


WELL PLUGGING RECORD

Give All Information Completely
Make Required Affidavit
Mail or Deliver Report to:
Conservation Division
State Corporation Commission
211 No. Broadway
Wichita, Kansas

Pratt County, Sec. 31 Twp. 27 Rge. 13 (E) (W)

NORTH

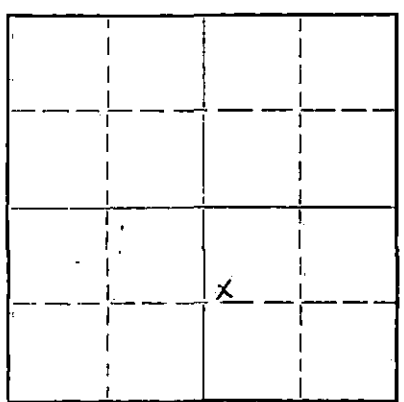

Locate well correctly on above Section Plat

Location as "NE/CNW/SW" or footage from lines SW NW SE
Lease Owner H. C. Bennett
Lease Name Greenstreet Well No. 1
Office Address 1212 Union National Bank Bldg., Wichita, Kansas
Character of Well (completed as Oil, Gas or Dry Hole) oil well
Date well completed 11-16-54 19
Application for plugging filed 6-1-65 19
Application for plugging approved 6-3-65 19
Plugging commenced 6-16-65 19
Plugging completed 6-21-65 19
Reason for abandonment of well or producing formation depleted

If a producing well is abandoned, date of last production 19
Was permission obtained from the Conservation Division or its agents before plugging was commenced? yes

Name of Conservation Agent who supervised plugging of this well Archie Flying
Producing formation Depth to top Bottom Total Depth of Well 4526 Feet
Show depth and thickness of all water, oil and gas formations.

OIL, GAS OR WATER RECORDS

CASING RECORD

FORMATION	CONTENT	FROM	TO	SIZE	PUT IN	PULLED OUT
				8 5/8	360	none
				5 1/2	4524	4010.88

Describe in detail the manner in which the well was plugged, indicating where the mud fluid was placed and the method or methods used in introducing it into the hole. If cement or other plugs were used, state the character of same and depth placed, from feet to feet for each plug set.

Fill hole with chat from 4493' to 4400' and dump 5 sacks cement.
Set 10' rock bridge from 270' to 260'. Mix and dump 2 sacks cement.
Let cement set up. Bailed hole dry to bridge at 260' and dumped 23 sacks cement. Mud hole to 40', set 10' rock bridge from 40' to 30' and dump 10 sacks cement.

RECEIVED
STATE CORPORATION COMMISSION
6-30-65
JUN 30 1965

(If additional description is necessary, use BACK of this sheet)
Name of Plugging Contractor Flint Engineering & Construction Company
Address Box 9540, El Dorado, Kansas

STATE OF KANSAS, COUNTY OF BUTLER, ss.
(employee of owner) or (owner or operator) of the above-described well, being first duly sworn on oath, says: That I have knowledge of the facts, statements, and matters herein contained and the log of the above-described well as filed and that the same are true and correct. So help me God.

(Signature) Laura Bawdle
El Dorado, Kansas

SUBSCRIBED AND SWORN TO before me this 28th day of June, 1965

My commission expires 9-27-67
Ronald P. Hawman Notary Public.

COPY

WELL LOG BUREAU—KANSAS GEOLOGICAL SOCIETY
508 East Murdock, Wichita, Kansas


Company- STERLING DRILLING CO., ET AL
Farm- Greenstreet No. 1

SEC. 31 T. 27 R. 13W
SW NW SE

Total Depth. 4528'
Comm. 10-4-54 Comp. 11-16-54
Shot or Treated.
Contractor. Sterling Drlg. Co.
Issued. 2-26-55

County Pratt

KANSAS

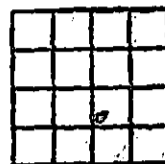

Elevation. 1930

Production. 18 B.

Figures Indicate Bottom of Formations.

sand	100
red bed-shale-shells	280
red bed-	600
shale-red bed	1690
limestone-shale	1900
limestone	2530
limestone-shale	2750
shale	3060
limestone-shale	3220
limestone	3760
shale	3820
limestone	4305
limestone-shale	4365
limestone-chert	4391
limestone-shale	4449
shale	4480
sand-shale	4510
limestone-shale	4528
Total Depth	

TOPS: Scout	
Heebner	3605
Lansing	3840
Mississippi	4290
Viola-	4330
Simpson	4390
Arbuckle	4510

CABLE TOOLS M.I.C.T. Swabbed
 Hole down, drilled cement. Perforated 4423-33 w/4 jets per foot. Bailed approximately 1/2 bbl. fluid per hr. estimated 15% oil. Perforated 4416-20 w/4 jets per foot. Bailed approximately 3/4 bbl. per hr. estimated 20% oil. Found 275' watery mud & 25' oil after 12 hrs. Ran tbg. & acidized w/750 gal. M.C.A. Sand Fractured with total of 200 bbl. crude & 13000# sand w/500# moth-balls, id-way during pumping. Swab back load oil. Hole filled up 1500' fluid for four consecutive days during load oil swabbing. Final swab rate 4 bbls. fluid per hr. estimated 50% wtr. P.O.P.

RECEIVED
STATE CORPORATION COMMISSION

JUN 30 1965

CONSERVATION DIVISION
Wichita, Kansas