

STATE OF KANSAS
STATE CORPORATION COMMISSION


Form CP-4

Give All Information Completely
Make Required Affidavit
Mail or Deliver Report to:
Conservation Division
State Corporation Commission
211 No. Broadway
Wichita, Kansas

WELL PLUGGING RECORD

Pratt County. Sec. 31 Twp. 27 Rge. 13 xxx (E) (W)

Location as "NE/CNW/SW" or footage from lines S₂ SE SW
Lease Owner H. C. Bennett
Lease Name Elliott A Well No. 2
Office Address 1212 Union National Bldg., Wichita, Kansas
Character of Well (completed as Oil, Gas or Dry Hole) oil well
Date well completed _____ 19____
Application for plugging filed 6-1-65 19____
Application for plugging approved 6-3-65 19____
Plugging commenced 7-2-65 19____
Plugging completed 7-13-65 19____
Reason for abandonment of well or producing formation depleted

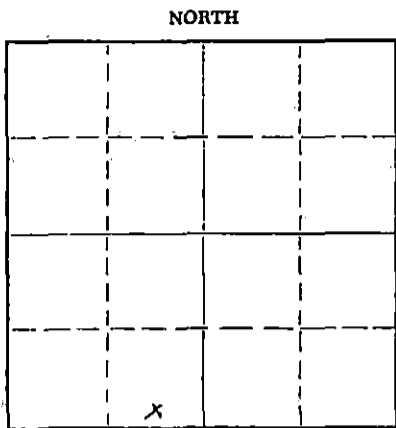

Locate well correctly on above Section Plat

If a producing well is abandoned, date of last production _____ 19____
Was permission obtained from the Conservation Division or its agents before plugging was commenced? yes

Name of Conservation Agent who supervised plugging of this well Archie Elving
Producing formation _____ Depth to top _____ Bottom _____ Total Depth of Well 4530 Feet
Show depth and thickness of all water, oil and gas formations.

OIL, GAS OR WATER RECORDS

CASING RECORD

FORMATION	CONTENT	FROM	TO	SIZE	PUT IN	PULLED OUT
				5/8	360	none
				5 1/2	4528	2426.53

Describe in detail the manner in which the well was plugged, indicating where the mud fluid was placed and the method or methods used in introducing it into the hole. If cement or other plugs used, state the character of same and depth placed, from _____ feet to _____ feet for each plug set.

Fill hole with chat from 4449' to 4400' and dump 5 sacks cement.
Set 10' rock bridge from 290' to 280' and mix and dump 2 sacks cement. Let set and bail hole dry. Dumped 23 sacks cement.
Mud hole to 40', set 10' rock bridge and dumped 10 sacks cement to surface.

RECEIVED
STATE CORPORATION COMMISSION
JUL 27 1965
27-65
CONSERVATION DIVISION
Wichita, Kansas

(If additional description is necessary, use BACK of this sheet)
Name of Plugging Contractor Flint Engineering & Construction Company
Address Box 950, El Dorado, Kansas

STATE OF KANSAS, COUNTY OF BUTLER, ss.

_____, (employee of owner) or (operator) of the above-described well, being first duly sworn on oath, says: That I have knowledge of the facts, statements, and matters herein contained and the log of the above-described well as filed and that the same are true and correct. So help me God.

(Signature) Chas. Bawalle
El Dorado, Kansas

SUBSCRIBED AND SWORN TO before me this 20th day of July, 1965

My commission expires 9-27-67

Ronald R. Hansen
Notary Public.

WELL LOG BUREAU—KANSAS GEOLOGICAL SOCIETY
508 East Murdock, Wichita, Kansas


COPY

Company— C. F. HERTLEIN-STERLING DRILLING CO.
Farm— Elliott "A" No. 2

SEC. 31 T. 27 R. 13W
CS/2 SE SW

Total Depth. 4530 PB 4449
Comm. 3-8-55 Comp. 4-5-55
Shot or Treated.
Contractor. Sterling Drlg Co.
Issued. 5-21-55

County Pratt
KANSAS

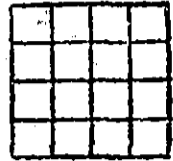

CASING:
8 5/8" 360' cem w/250 sx
5 1/2" 4528' cem w/150 sx

Elevation. 1926 R.B.

Production. 1213 BO

Figures indicate Bottom of Formations

shale, sand	110
red bed	260
red bed, shale	760
anhydrite	790
shale, shells	815
red bed, shale, shells	1415
shale, red bed	1715
shale, limestone	3370
limestone	3750
limestone, shale, sand	3800
shale, limestone	3865
limestone	4250
shale, limestone	4295
limestone, chert	4350
shale, chert	4370
limestone, chert	4413
sand Simpson	4473
limestone, shale	4500
limestone	4530
Total Depth	
P. B. 4449	

Tops: Scout	
Heebner	3565
Douglas	3730
Lansing	3840
Mississippian	4315
Viola	4370
Simpson	4400
Arbuckle	4510

CABLE TOOLS: M.I.C.T.
C.O. to PBD 4449. Perf.
4420-24 w/4 jets per ft.
Rec. 5 gal. mud, few oil
specks. Perf. 4416-20
w/4 jets per ft. After 1
hr. rec. 5 gal. heavily
oil cut mud. Fractured
w/200 bbls heavy crude
& 8500# sand. Treating
press. 3500 psi to 3100
psi. Pumped 250 gal. mud
acid ahead of fracture.
Swabbed 150 bbls load oil
& well kicked off flowing.
M.O.C.T.

RECEIVED
STATE CORPORATION COMMISSION

AUG 4 - 1965

CONSERVATION DIVISION
Wichita, Kansas