

plugged 11-16-87

STATE CORPORATION COMMISSION OF KANSAS
OIL & GAS CONSERVATION DIVISION
WELL COMPLETION OR RECOMPLETION FORM
ACO-1 WELL HISTORY
DESCRIPTION OF WELL AND LEASE

Operator: License # 5104
Name Blue Goose Drilling Co., Inc.
Address P.O. Box 1413
Great Bend, KS 67530
City/State/Zip

Purchaser

Operator Contact Person Martin E. Miller
Phone 316 792-5633

Contractor: License # same
Name Company Tools

Wellsite Geologist Daniel R. Sommer
Phone 303 794-0062

Designate Type of Completion
 New Well Re-Entry Workover
 Oil SWD Temp Abd
 Gas Inj Delayed Comp.
 Dry Other (Core, Water Supply etc.)
If OWWO: old well info as follows:

Operator
Well Name
Comp. Date Old Total Depth

WELL HISTORY

Drilling Method:
 Mud Rotary Air Rotary Cable
11/5/87 11/16/87 11/16/87
Spud Date Date Reached TD Completion Date
5300 N/A
Total Depth PBTD

Amount of Surface Pipe Set and Cemented at 347' feet
Multiple Stage Cementing Collar Used? Yes No
If yes, show depth set feet
If alternate 2 completion, cement circulated
from 347' feet depth to surface w/.190 SX cmt
Cement Company Name Allied
Invoice # 50190

API NO. 15-069-20,221-0000
County Gray
SW SW NE Sec. 7 Twp. 27 Rge. 29 East
2970 Ft North from Southeast Corner of Section
2310 Ft West from Southeast Corner of Section
(Note: Locate well in section plat below)


Lease Name Koehn Well # 1

Field Name Wildcat

Producing Formation

Elevation: Ground 2751 KB 2761

Section Plat

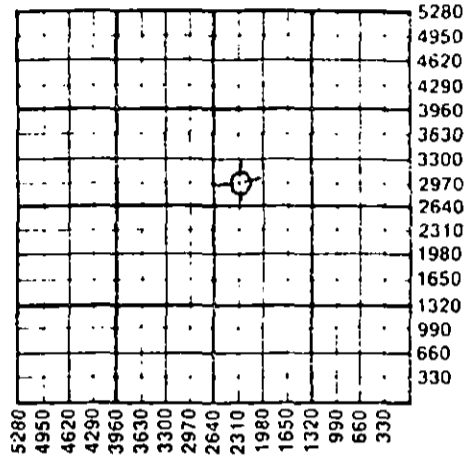

WATER SUPPLY INFORMATION

Disposition of Produced Water: Disposal
Docket # Repressuring

Questions on this portion of the ACO-1 call:
Water Resources Board (913) 296-3717

Source of Water:
Division of Water Resources Permit # T-87-476
ownership transferred to landowner. Letter attached.
 Groundwater 2970 Ft North from Southeast Corner
(Well) 2310 Ft West from Southeast Corner of
Sec 7 Twp 27 Rge 29 East West
 Surface Water Ft North from Southeast Corner
(Stream, pond etc) Ft West from Southeast Corner
Sec Twp Rge East West
 Other (explain)
(purchased from city, R.W.D. #)

INSTRUCTIONS: This form shall be completed in triplicate and filed with the Kansas Corporation Commission, 200 Colorado Derby Building, Wichita, Kansas 67202, within 120 days of the spud date of any well. Rule 82-3-130, 82-3-107 and 82-3-106 apply.
Information on side two of this form will be held confidential for a period of 12 months if requested in writing and submitted with the form. See rule 82-3-107 for confidentiality in excess of 12 months.
One copy of all wireline logs and drillers time log shall be attached with this form. Submit CP-4 form with all plugged wells. Submit CP-111 form with all temporarily abandoned wells.

All requirements of the statutes, rules and regulations promulgated to regulate the oil and gas industry have been fully complied with and the statements herein are complete and correct to the best of my knowledge.

Signature [Signature]

Title Contracts/Exploration Date 11/30/87

Subscribed and sworn to before me this 14th day of December 1987

Notary Public [Signature]

Date Commission Expires



K.C.C. OFFICE USE ONLY
 Letter of Confidentiality Attached
 Wireline Log Received
 Drillers Timelog Received
Distribution
 KCC SWD/Rep NGPA
 KGS Plug Other
(Specify)

Form ACO-1 (5-86)

DEC 5 1987
RCD 12-6-87
CONSERVATION DIVISION
Wichita, Kansas

Sec. 7, Twp. 27 Rge. 29

Operator Name Blue Goose Drilling Co., Inc. Lease Name Koehn Well # 1

Sec. 7 Twp. 27 Rge. 29 East West County Gray

WELL LOG

INSTRUCTIONS: Show important tops and base of formations penetrated. Detail all cores. Report all drill stem tests giving interval tested, time tool open and closed, flowing and shut-in pressures, whether shut-in pressure reached static level, hydrostatic pressures, bottom hole temperature, fluid recovery, and flow rates if gas to surface during test. Attach extra sheet if more space is needed. Attach copy of log.

Drill Stem Tests Taken Yes No
 Samples Sent to Geological Survey Yes No
 Cores Taken Yes No

NO DST's

Formation Description
 Log Sample

Name	Top	Bottom
Anhydrite	1760' (+1001)	
Heebner	4153' (-1392)	
Toronto	4170' (-1409)	
Lansing	4256' (-1495)	
Stark Shale	4538' (-1777)	
Marmaton	4654' (-1893)	
Pawnee	4802' (-2041)	
Cherokee	4840' (-2079)	
St. Genevieve	5020' (-2259)	
St. Louis	5078' (-2317)	
Spergen	5280' (-2519)	

Letter of Confidentiality Attached

RELEASED

JAN 11 1989

FROM CONFIDENTIAL

CASING RECORD <input checked="" type="checkbox"/> New <input type="checkbox"/> Used Report all strings set-conductor, surface, intermediate, production, etc.							
Purpose of String	Size Hole Drilled	Size Casing Set (in O.D.)	Weight Lbs/Ft.	Setting Depth	Type of Cement	#Sacks Used	Type and Percent Additives
Surface	12 1/4"	8 5/8"	20	347	60/40 pos	190	3%cc 2% gel
PERFORATION RECORD				Acid, Fracture, Shot, Cement Squeeze Record (Amount and Kind of Material Used) Depth			
Shots Per Foot	Specify Footage of Each Interval Perforated						
TUBING RECORD				Size	Set At	Packer at	Liner Run <input type="checkbox"/> Yes <input type="checkbox"/> No
Date of First Production	Producing Method <input type="checkbox"/> Flowing <input type="checkbox"/> Pumping <input type="checkbox"/> Gas Lift <input type="checkbox"/> Other (explain).....						
Estimated Production Per 24 Hours	Oil	Gas	Water	Gas-Oil Ratio	Gravity		
	Bbls	MCF	Bbls	CFPB			

METHOD OF COMPLETION

Production Interval

Disposition of gas: Vented Open Hole Perforation
 Sold Other (Specify)
 Used on Lease Dually Completed
 Commingled

OILFIELD WATER SUPPLY WELL-LETTER OF OWNERSHIP TRANSFER

I, BEN H. KOEHN of INDEPENDENCE, KANSAS RT. 1,
NAME OF LANDOWNER LANDOWNER'S ADDRESS

am the owner of the S 1/4 S 1/4 N 1/4 in SEC. 7, T 27 S, R 29 W in

GRAY County, KS, on which a water well was drilled in NOVEMBER
1987 MONTH

I hereby request that BLUE GOOSE DRILLING CO. INC. leave this water well
OIL/GAS DRILLING COMPANY
open for my own use. I will assume all responsibility for the further
completion, maintenance and plugging under Article 30 of the water well
construction regulations of the State of Kansas as adopted by the Kansas
Department of Health and Environment.

B. H. Koehn
SIGNATURE OF LANDOWNER

11-16-87
DATE

Blue Goose Drilling Co. Inc.
George E. Muller Jr.
SIGNATURE OF COMPANY

11-16-87
DATE

KANSAS GEOLOGICAL SURVEY
WICHITA BRANCH

RELEASED

JAN 11 1989

FROM CONFIDENTIAL