

STATE CORPORATION COMMISSION OF KANSAS
OIL & GAS CONSERVATION DIVISION
WELL COMPLETION OR RECOMPLETION FORM
ACO-1 WELL HISTORY
DESCRIPTION OF WELL AND LEASE

Operator: License # 5118
Name TGT Petroleum Corp.
Address 209 E. William
Suite 615
City/State/Zip Wichita, Ks. 67202

Purchaser N/A

Operator Contact Person B. Lynn Herrington
Phone 262-6489

Contractor: License # 5422
Name Abercrombie Drilling, Inc.

Wellsite Geologist Al Stude
Phone 943-4361

Designate Type of Completion
 New Well Re-Entry Workover

 Oil SWD Temp Abd
 Gas Inj Delayed Comp.
 Dry Other (Core, Water Supply etc.)

If ONWO: old well info as follows:
Operator
Well Name
Comp. Date Old Total Depth

WELL HISTORY

Drilling Method:
 Mud Rotary Air Rotary Cable

6-11-89 6-22-89 7/18/89
Spud Date Date Reached TD Completion Date

5200' 5200'
Total Depth PBTD
411.91
Amount of Surface Pipe Set and Cemented at...feet
Multiple Stage Cementing Collar Used? Yes No
If yes, show depth set...feet
If alternate 2 completion, cement circulated
from...feet depth to...w/...SX cmt
Cement Company Name
Invoice #

API NO. 15-097-21,274-0000

County Kiowa
145' S of
NW NE NW Sec. 10 Twp. 27S Rge. 19 East
West

4805 Ft North from Southeast Corner of Section
3630 Ft West from Southeast Corner of Section
(Note: Locate well in section plat below)


Lease Name Barrett (#2) Well # SWD

Field Name Quaker

Producing Formation N/A

Elevation: Ground 2249 2261 KB

Section Plat

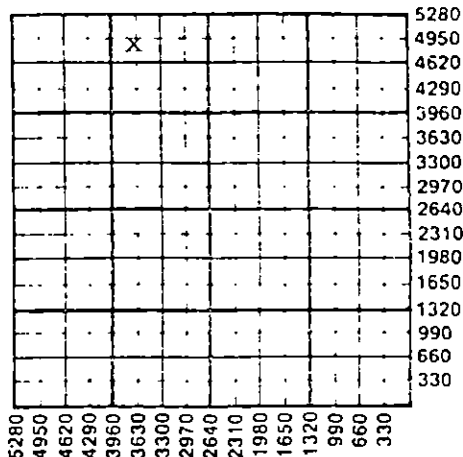

WATER SUPPLY INFORMATION

Disposition of Produced Water: Disposal
Docket # Repressuring

Questions on this portion of the ACO-1 call:

Water Resources Board (913) 296-3717

Source of Water:
Division of Water Resources Permit # T. 89-278

Groundwater 4750 Ft North from Southeast Corner
(Well) 3530 Ft West from Southeast Corner of
Sec 10 Twp 27S Rge 19 East West

Surface Water...Ft North from Southeast Corner
(Stream, pond etc)...Ft West from Southeast Corner
Sec Twp Rge: East West


Other (explain) (purchased from city, R.W.D. #)

INSTRUCTIONS: This form shall be completed in triplicate and filed with the Kansas Corporation Commission, 200 Colorado Derby Building, Wichita, Kansas 67202, within 120 days of the spud date of any well. Rule 82-3-130, 82-3-107 and 82-3-106 apply. Information on side two of this form will be held confidential for a period of 12 months if requested in writing and submitted with the form. See rule 82-3-107 for confidentiality in excess of 12 months. One copy of all wireline logs and drillers time log shall be attached with this form. Submit CP-4 form with all plugged wells. Submit CP-111 form with all temporarily abandoned wells.

All requirements of the statutes, rules and regulations promulgated to regulate the oil and gas industry have been fully complied with and the statements herein are complete and correct to the best of my knowledge.

Signature B. Lynn Herrington
Title Executive Vice-President Date 10/5/89

Subscribed and sworn to before me this 5th day of October 1989
Notary Public Judith K. Moser
Date Commission Expires May 17, 1993

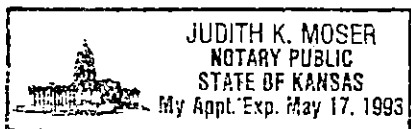

K.C.C. OFFICE USE ONLY
F Letter of Confidentiality Attached
C Wireline Log Received
C Drillers Timelog Received
Distribution
 KCC SWD/Rep NGPA
 KGS Plug Other (Specify)

pi X