

STATE CORPORATION COMMISSION OF KANSAS  
OIL & GAS CONSERVATION DIVISION

WELL COMPLETION OR RECOMPLETION FORM  
ACO-1 WELL HISTORY

DESCRIPTION OF WELL AND LEASE

Operator: License # 5652  
Name Mustang Drilling & Exploration, Inc.  
Address P.O. Box 1609  
Great Bend, Kansas 67530  
City/State/Zip

Purchaser

Operator Contact Person J.P. Meroney  
Phone 316 792 7323

Contractor: License # 4813  
Name Mustang Drilling, Inc.

Wellsite Geologist Gary Holstin  
Phone 316 788 4570

Designate Type of Completion

New Well  Re-Entry  Workover

Oil  SWD  Temp Abd  
 Gas  Inj  Delayed Comp.  
 Dry  Other (Core, Water Supply etc.)

If OWWO: old well info as follows:

Operator  
Well Name  
Comp. Date Old Total Depth

WELL HISTORY

Drilling Method:

Mud Rotary  Air Rotary  Cable

3-12-86 3-22-86 3-22-86  
Spud Date Date Reached TD Completion Date

5417'  
Total Depth PBDT

Amount of Surface Pipe Set and Cemented at 1715' feet  
Multiple Stage Cementing Collar Used?  Yes  No

If yes, show depth set... feet  
If alternate 2 completion, cement circulated  
from... feet depth to... w/... SX cmt

API NO. 15-15-187-20,404-0000  
County Stanton  
C NW NE Sec. 25 Twp. 27S Rge. 41W  East  West

4620 Ft North from Southeast Corner of Section  
1980 Ft West from Southeast Corner of Section  
(Note: Locate well in section plat below)


Lease Name Lane Well # 1-25

Field Name

Producing Formation

Elevation: Ground 3297' KB 3307'

Section Plat

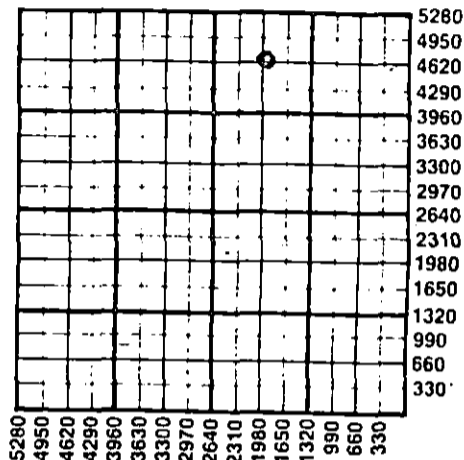

WATER SUPPLY INFORMATION

Disposition of Produced Water:  Disposal  Repressuring  
Docket #

Questions on this portion of the ACO-1 call:

Water Resources Board (913) 296-3717

Source of Water:  
Division of Water Resources Permit #

Groundwater... Ft North from Southeast Corner (Well) ... Ft West from Southeast Corner  
Sec Twp Rge  East  West

Surface Water... Ft North from Southeast Corner (Stream, pond etc)... Ft West from Southeast Corner  
Sec Twp Rge  East  West


Other (explain) purchased from landowner  
(purchased from city, R.W.D. #)

INSTRUCTIONS: This form shall be completed in duplicate and filed with the Kansas Corporation Commission, 200 Colorado Derby Building, Wichita, Kansas 67202, within 90 days after completion or recompletion of any well. Rule 82-3-130 and 82-3-107 apply.  
Information on side two of this form will be held confidential for a period of 12 months if requested in writing and submitted with the form. See rule 82-3-107 for confidentiality in excess of 12 months.  
One copy of all wireline logs and drillers time log shall be attached with this form. Submit CP-4 form with all plugged wells. Submit CP-111 form with all temporarily abandoned wells.

All requirements of the statutes, rules and regulations promulgated to regulate the oil and gas industry have been fully complied with and the statements herein are complete and correct to the best of my knowledge.

Signature [Signature] Title Exploration Manager Date 4-3-86

Subscribed and sworn to before me this 3rd day of April 1986  
Notary Public Darlene J. May  
Date Commission Expires 8-28-88

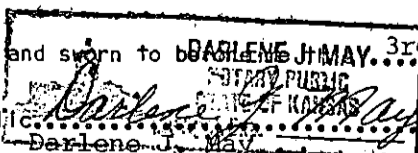

K.C.C. OFFICE USE ONLY  
 Letter of Confidentiality Attached  
 Wireline Log Received  
 Drillers Time Log Received  
Distribution  
 KCC  SWD/Rep  NGPA  
 KGS  Plug  Other (Specify)

Sec. 25 Twp. 27 Rge. 41 W