


STATE OF KANSAS
STATE CORPORATION COMMISSION

WELL PLUGGING RECORD

Give All Information Completely
Make Required Affidavit
Mail or Deliver Report to:
Conservation Division
State Corporation Commission
P. O. Box 17027
Wichita, Kansas 67217
NORTH

Kiowa County, Sec. 5 Twp. 27S Rge. ~~X~~ 19W (W)
C NE NW

Location as "NE/CNW/SW" or footage from lines
Lease Owner Pickrell Drilling Company
Lease Name Miller "Y" Well No. 1
Office Address 705 Fourth National Bank Bldg., Wichita, Kansas 67202
Character of Well (completed as Oil, Gas or Dry Hole) Dry Hole
Date well completed January 7 19 73
Application for plugging filed January 7 19 73
Application for plugging approved January 7 19 73
Plugging commenced January 7 19 73
Plugging completed January 7 19 73
Reason for abandonment of well or producing formation Dry Hole

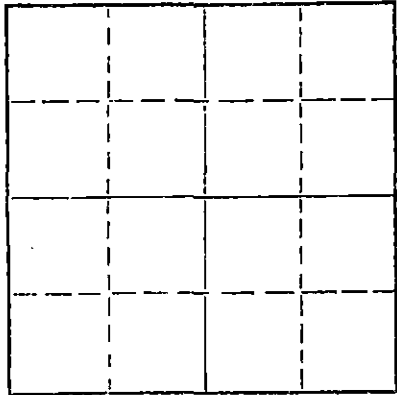

Locate well correctly on above Section Plat

If a producing well is abandoned, date of last production 19
Was permission obtained from the Conservation Division or its agents before plugging was commenced? Yes

Name of Conservation Agent who supervised plugging of this well G. Russell Biberstein
Producing formation _____ Depth to top _____ Bottom _____ Total Depth of Well 4840 Feet
Show depth and thickness of all water, oil and gas formations.

OIL, GAS OR WATER RECORDS

CASING RECORD

FORMATION	CONTENT	FROM	TO	SIZE	PUT IN	PULLED OUT
				8-5/8"	363'	NONE

Describe in detail the manner in which the well was plugged, indicating where the mud fluid was placed and the method or methods used in introducing it into the hole. If cement or other plugs were used, state the character of same and depth placed, from _____ feet to _____ feet for each plug set.

Bottom Plug @ 330' w/35 sacks, Top Plug @ 45' w/15 Sacks.

RECEIVED
STATE CORPORATION COMMISSION
JAN 17 1973
1-12-73
CONSERVATION DIVISION
Wichita, Kansas


(If additional description is necessary, use BACK of this sheet)
Name of Plugging Contractor Pickrell Drilling Company
Address 705 Fourth National Bank Building, Wichita, Kansas 67202

STATE OF Kansas, COUNTY OF Sedgwick, ss.
C. W. Sebitts (employee of owner) or (owner or operator) of the above-described

well, being first duly sworn on oath, says: That I have knowledge of the facts, statements, and matters herein contained and the log of the above-described well as filed and that the same are true and correct. So help me God.

(Signature) [Signature]
C. W. Sebitts
705 Fourth National Bank Bldg., Wichita, Kansas
(Address)

Subscribed and sworn to before me this 15th day of January, 19 73
January 19, 1977

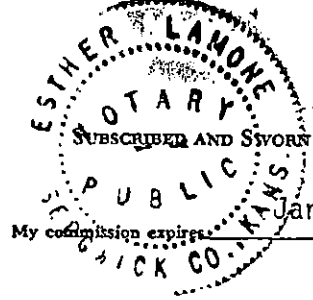

Esther Lamone
Notary Public.

My commission expires _____

ROTARY DRILLING LOG

COMPANY: Pickrell Drilling Company
705 Fourth National Bank Building
Wichita, Kansas 67202

Rotary Drilling Commenced 12/23/72

Rotary Drilling Completed 1/7/73

LOCATION: Miller "Y" No. 1, C NE NW Section 5-27S-19W
Kiowa County, Kansas

CONTRACTOR: **PICKRELL DRILLING COMPANY**
Wichita, Kansas

CASING RECORD: Run 9 Jts. 8-5/8" surface casing set @ 363' KB. Cemented w/225 sacks. Completed 2:45 P.M. Circulated.

No oil string run. D & A. Plugged 7:30 P.M. January 7, 1973.

LOG

(Figures indicate bottom of formation — measurements from top of rotary bushing.)

160	Sand	C.F.S.
240	Shale	4232
255	Sand	4260
365	Shale & Sandy Shale	4325
700	Shale - Sand	4390
980	Red Beds - Shale	4800
1279	Shale	4804
1312	Anhydrite	4810
1975	Shale & Shells	4828
2330	Shale & Lime	4840
3445	Lime	
3935	Lime - Shale	
4075	Lime	
4170	Lime & Shale	
4800	Lime	<u>Slope Tests</u>
4804	Sand	2000
4805	Lime	2500
4840	Mississippian, RTD	3000
		3500
		4000
		4500

RECEIVED
STATE CORPORATION COMMISSION
JAN 17 1973
CONSERVATION DIVISION
Wichita, Kansas


The undersigned, C. W. Sebitts, Attorney-in-Fact for PICKRELL DRILLING COMPANY, hereby certifies in behalf of said Company, that the above is a true and correct log of the formation encountered in drilling the above well as reflected by the Daily Drilling Reports.

PICKRELL DRILLING COMPANY
By *[Signature]*
C. W. Sebitts Attorney-in-Fact

STATE OF KANSAS }
COUNTY OF SEDGWICK } ss.:

On this 15th day of January, 19 73, before me the undersigned, a Notary Public, in and for the County and State aforesaid, personally appeared C. W. Sebitts, to me known to be the identical person who subscribed the name of PICKRELL DRILLING COMPANY to the foregoing instrument as its Attorney-in-Fact and acknowledged to me that he executed the same as his free and voluntary act and deed, and as the free and voluntary act and deed of such company, for the uses and purposes therein set forth.

Given under my hand and seal of office the day and year last above written.

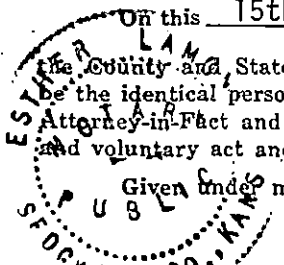

My commission expires: January 19, 1977

[Signature]
Esther Lamone Notary Public