

STATE OF KANSAS
STATE CORPORATION COMMISSION


WELL PLUGGING RECORD

Give All Information Completely
Make Required Affidavit
Mail or Deliver Report to:
Conservation Division
State Corporation Commission
800 Bitting Building
Wichita, Kansas

Kiowa County. Sec. 15 Twp. 27S Rge. (E) 19 (W)

Location as "NE/CNWxSWx" or footage from line App Ctr SW SE
Lease Owner Grahamart-Miller Oil Company
Lease Name Farrar Well No. 1
Office Address 1005 East Second, Wichita, Kansas
Character of Well (completed as Oil, Gas or Dry Hole) Dry Hole
Date well completed August 2, 1955 19
Application for plugging filed August 3, 1955 19
Application for plugging approved August 4, 1955 19
Plugging commenced August 9, 1955 19
Plugging completed August 11, 1955 19
Reason for abandonment of well or producing formation Dry Hole

NORTH

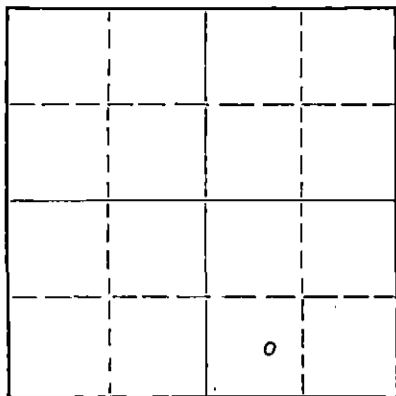

Locate well correctly on above
Section Plat

If a producing well is abandoned, date of last production _____ 19
Was permission obtained from the Conservation Division or its agents before plugging was commenced? Yes

Name of Conservation Agent who supervised plugging of this well M. A. Rives, Box 8, Pratt, Kansas
Producing formation _____ Depth to top _____ Bottom _____ Total Depth of Well 4840 Feet
Show depth and thickness of all water, oil and gas formations.

OIL, GAS OR WATER RECORDS

CASING RECORD

FORMATION	CONTENT	FROM	TO	SIZE	PUT IN	PULLED OUT
				8 5/8	535	None
				5 1/2	4840	4180

Describe in detail the manner in which the well was plugged, indicating where the mud fluid was placed and the method or methods used in introducing it into the hole. If cement or other plugs were used, state the character of same and depth placed, from _____ feet to _____ feet for each plug set.

Plugged back to 4790'. Put in
5 sacks cement. Mud to 525'.
Put in rock bridge and dumped
20 sacks cement. Mud to 35'
and dumped 10 sacks cement

(If additional description is necessary, use BACK of this sheet)

Name of Plugging Contractor J&M Casing Pulling Company
Address Box 711, Great Bend, Kansas

STATE OF Kansas, COUNTY OF Sedgwick, ss.
Roger L. Messman (employee of owner) or (owner or operator) of the above-described well, being first duly sworn on oath, says: That I have knowledge of the facts, statements, and matters herein contained and the log of the above-described well as filed and that the same are true and correct. So help me God.

(Signature) Roger L. Messman
1005 East Second, Wichita, Kansas
(Address)

SUBSCRIBED AND SWORN TO before me this 12th day of August, 19 55

My commission expires November 5, 1958

Junita L. Lovie
Notary Public.

RECEIVED
STATE CORPORATION COMMISSION

PLUGGING
FILED SEC 15 T 27 R 19W
BOOK PAGE 139 LINE 42

NO. 1 FARRAR

WELL RECORD

Location: App Ctr SW SE, 15-273-19W
Kiowa County, Kansas

Commenced: July 3, 1955

Operator: Gramhart-Killer Oil Company
1005 East Second, Wichita, Kansas

Completed: July 19, 1955 (w/rty)

Elevation: 2247 KB

Contractor: Graham-Messman-Rinehart Drilling Co.
1005 East Second, Wichita, Kansas

Production:

Casing Record: 8 5/8" @ 535' w/300 sacks cement
5 1/2" @ 4840' w/75 sacks cement

.....L O G.....

Sand-Clay	470
Sand-Shale	537
Shale-Red Bed	1140
Shale-Anhydrite	1685
Shale	2140
Lime-Shale	2355
Shale-Anhydrite	2520
Shale-Lime	3079
Lime-Shale	3165
Shale-Lime	3480
Lime-Shale	3564
Shale-Lime	3675
Lime-Shale	3904
Shale-Lime	4025
Lime-Shale	4198
Lime	4308
Lime-Shale	4375
Shale-Lime	4422
Lime-Shale	4485
Lime	4540
Shale-Lime	4580
Lime	4788
Mississippi	4840 R.T.D.

Sample Tops:

Heebner 4032 (-1785)
 Toronto 4050 (-1803)
 Br. Lime 4188 (-1941)
 Lansing 4192 (-1945)
 Cherokee Sd 4769 (-2522)
 Miss. Chert 4773 (-2526)

PH A 149
270 SW
1075000
57 M-F
4788 to 4800
4801 to 4805
30 ft x 12 in
has to surface
820 del
3305
BHP 1480

The undersigned, GRAHAM-MESSMAN-RINEHART DRILLING COMPANY, hereby certifies that the above log is a true and correct log of the formation encountered in drilling the above well as reflected by the Daily Drilling Report.

GRAHAM-MESSMAN-RINEHART DRILLING COMPANY

BY: Roger L. Messman
Roger L. Messman

Subscribed and sworn to before me this 27th day of July, 1955.

Jessita L. Lewis
Notary Public

My Commission Expires: November 5, 1958

PLUGGING
 FILE SEC 15727-R-19W
 BOOK PAGE 139 LINE 42