

STATE OF KANSAS


STATE CORPORATION COMMISSION

WELL PLUGGING RECORD

Give All Information Completely
Make Required Affidavit
Mail or Deliver Report to
Conservation Division
State Corporation Comm.
245 North Water
Wichita, KS 67202

Kiowa County, Sec. 15 Twp. 27S Rge. 19W E/W
Location as "NE/CNW 1/4 SW 1/4" or footage from lines
SE NW

Lease Owner PICKRELL DRILLING COMPANY
Lease Name Davis "K" Well No. 1
Office Address 205 LITWIN BLDG., WICHITA, KS. 67202
Character of Well (Completed as Oil, Gas or Dry Hole)

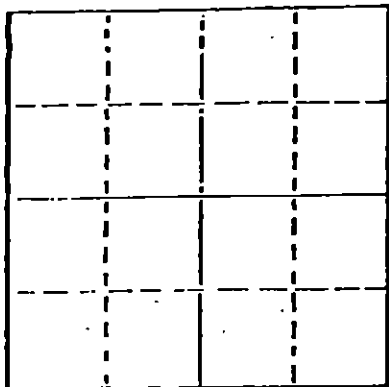

Locate well correctly on above Section Plat

Date Well completed Dry Hole 19
Application for plugging filed 11-03-77 19
Application for plugging approved 11-03-77 19
Plugging commenced 11-03-77 19
Plugging completed 11-03-77 19
Reason for abandonment of well or producing formation
Dry Hole

If a producing well is abandoned, date of last production 19

Was permission obtained from the Conservation Division or its agents before plugging was commenced? Yes

Name of Conservation Agent who supervised plugging of this well Jasper H. Metz

Producing formation Depth to top Bottom Total Depth of Well 4833

Show depth and thickness of all water, oil and gas formations.

OIL, GAS OR WATER RECORDS

CASING RECORD

Table with 7 columns: FORMATION, CONTENT, FROM, TO, SIZE, PUT IN, PULLED OUT. Row 1: 8 5/8, 256, None.

Describe in detail the manner in which the well was plugged, indicating where the mud fluid was placed and the method or methods used in introducing it into the hold. If cement or other plugs were used, state the character of same and depth placed, from feet to feet for each.

RECEIVED
STATE CORPORATION COMMISSION
DEC 05 1977
CONSERVATION DIVISION
Wichita, Kansas

35 sx. @ 256'
12 sx. @ 40'
3 sx. in Rat Hole Comp. IOPM 11-03-77

(If additional description is necessary, use BACK of this sheet)

Name of Plugging Contractor PICKRELL DRILLING COMPANY

STATE OF Kansas COUNTY OF Sedgwick, ss.
C. W. Sebitts (employee of owner) or (owner or operator)
of the above-described well, being first duly sworn on oath, says: That I have knowledge of the facts, statements, and matters herein contained and the log of the above-described well as filed and that the same are true and correct. So help me God By: C. W. Sebitts

(Signature) [Handwritten Signature]
205 Litwin Bldg., Wichita, Ks. 67202
(Address)

SUBSCRIBED AND SWORN TO before me this 8 day of November, 19 77



[Handwritten Signature]
Jo Ann Sarver Notary Public.

My commission expires

ROTARY DRILLING LOG

COMPANY: PICKRELL DRILLING COMPANY
 205 LITWIN BLDG.,
 WICHITA, KS. 67202

LOCATION: DAVIS K #1
 SE NW 15-27S-19W
 Kiowa Co., Ks.

CONTRACTOR: **PICKRELL DRILLING COMPANY**
Wichita, Kansas

Rotary Drilling Commenced 10-22-77
 Rotary Drilling Completed 11-03-77

CASING RECORD:
 Spud date 10-22-77 Surface pipe 8 5/8" set at 256' with 175sx.
 Comp. 10-22-75 10:45PM

LOG

(Figures indicate bottom of formation — measurements from top of rotary bushing.)

Sand	235
Shale	260
Sd, Shale, Redbed	667
Shale	681
Shale & Shells	1247
Shale	1280
Redbed-Shale	1860
Shale	1875
Shale	2285
Shale & Lime	2460
Shale & Lime	2463
Lime & Shale	2723
Lime & Shale	2868
Lime & Shale	3000
Shale & Lime	3150
Lime & Shale	3310
Lime & Shale	3465
Lime & Shale	3612
Lime & Shale	3777
Lime & Shale	4035
Shale & Lime	4168
Lime & Shale	4230
Lime	4265
Lime	4290
Lime	4400
Lime	4505
Lime	4612
Lime	4704
Lime	4782
Lime	4815
Lime	4823
Lime	4833

RECEIVED
 STATE CORPORATION COMMISSION
 DEC 05 1977
 CONSERVATION DIVISION
 Wichita, Kansas

The undersigned, C. W. Sebitts, Attorney-in-Fact for PICKRELL DRILLING COMPANY, hereby certifies in behalf of said Company, that the above is a true and correct log of the formation encountered in drilling the above well as reflected by the Daily Drilling Reports.

PICKRELL DRILLING COMPANY
 By [Signature]
 Attorney-in-Fact

STATE OF KANSAS }
 COUNTY OF SEDGWICK } ss.:

C. W. Sebitts

On this 8 day of November, 1977, before me the undersigned, a Notary Public, in and for

the County and State aforesaid, personally appeared C. W. Sebitts, to me known to be the identical person who subscribed the name of PICKRELL DRILLING COMPANY to the foregoing instrument as its Attorney-in-Fact and acknowledged to me that he executed the same as his free and voluntary act and deed, and as the free and voluntary act and deed of such company, for the uses and purposes therein set forth.

Given under my hand and seal of office the day and year last above written.

My commission expires:



[Signature]
 Notary Public
 Jo Ann Sarver