


15-007-01012-00-00

Give All Information Completely
Make Required Affidavit
Mail or Deliver Report to:
Conservation Division
State Corporation Commission
212 North Market, Insurance Bldg.
Wichita, Kansas

WELL PLUGGING RECORD

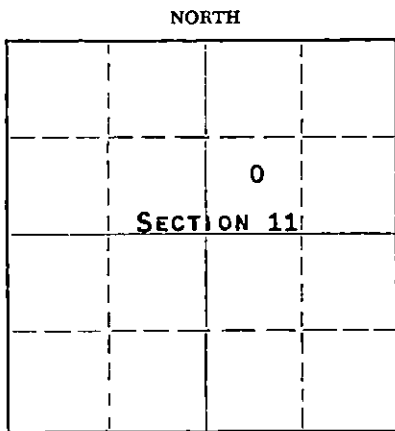

Locate well correctly on above Section Plat

BARBER County. Sec. 11 Twp. 33S Rge. 11W (E) (W)
Location as "NE/CNW&SW" or footage from lines C SW NE
Lease Owner PETROLEUM, INC.
Lease Name DAVIS "I" Well No. 1
Office Address ROUTE 2, GREAT BEND, KANSAS
Character of Well (completed as Oil, Gas or Dry Hole) DRY HOLE
Date well completed OCTOBER 2 1959
Application for plugging filed OCTOBER 2 1959
Application for plugging approved OCTOBER 2 1959
Plugging commenced OCTOBER 2 1959
Plugging completed OCTOBER 2 1959
Reason for abandonment of well or producing formation NO PRODUCIBLE ZONES

If a producing well is abandoned, date of last production NONE 19
Was permission obtained from the Conservation Division or its agents before plugging was commenced? YES

Name of Conservation Agent who supervised plugging of this well W. L. LACKAMP, STAFFORD, KANSAS
Producing formation Depth to top Bottom Total Depth of Well 4570 Feet
Show depth and thickness of all water, oil and gas formations.

OIL, GAS OR WATER RECORDS

CASING RECORD

FORMATION	CONTENT	FROM	TO	SIZE	PUT IN	PULLED OUT
				8-5/8"	209'	NONE

Describe in detail the manner in which the well was plugged, indicating where the mud fluid was placed and the method or methods used in introducing it into the hole. If cement or other plugs were used, state the character of same and depth placed, from feet to feet for each plug set.

MUD UP WITH HEAVY MUD TO 200' FOLLOWED BY A WOODEN PLUG AND 1/4 SACK OF HULLS. PLACED 20 SACKS OF CEMENT THROUGH DRILL PIPE ON TOP OF PLUG. MUD UP TO 35' FOLLOWED BY A WOODEN PLUG AND 1/4 SACK OF HULLS. FILLED HOLE TO BASE OF WELL CELLAR WITH 10 SACKS OF CEMENT.

RECEIVED
STATE CORPORATION COMMISSION
OCT 23 1959
CONSERVATION DIVISION
Wichita, Kansas

(If additional description is necessary, use BACK of this sheet)
Name of Plugging Contractor GARVEY DRILLING COMPANY
Address ROUTE 2, GREAT BEND, KANSAS

STATE OF KANSAS, COUNTY OF BARTON, ss.
DON SEARLE (employee of owner) or ~~*****~~ of the above-described well, being first duly sworn on oath, says: That I have knowledge of the facts, statements, and matters herein contained and the log of the above-described well as filed and that the same are true and correct. So help me God.

(Signature) Don Searle
ROUTE 2, GREAT BEND, KANSAS
(Address)

SUBSCRIBED AND SWORN to before me this 19TH day of OCTOBER, 1959

My commission expires APRIL 14, 1963
Arthur J. Wiles
ARTHUR J. WILES Notary Public.



WELL LOG

COMPANY PETROLEUM, INCORPORATED

SEC. 11 T. 33S. 11W

FARM DAVIS "I" NO. 1


LOC. C-SW, NE

TOTAL DEPTH 4570'

COUNTY BARBER CO., KANSAS

COMM. September 15, 1959 COMP. October 2, 1959

CONTRACTOR GARVEY DRILLING COMPANY

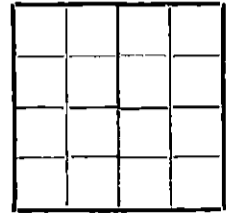

CASING 8 5/8" @ 209' W/175 sax.

ELEVATION 1514 DF

PRODUCTION D & A

FIGURES INDICATE BOTTOM OF FORMATIONS

209	Surface soil & red bed
575	Red bed
1570	Shale & shells
1700	Lime
2500	Lime & shale
2990	Shale & lime
3110	Lime & shale
3315	Lime
3455	Lime & shale
3600	Shale & lime
3685	Lime
3716	Lime & shale
3725	Sand
3800	Shale
3875	Lime & shale
4450	Lime
4485	Lime & shale
4570	Lime
4570	T. D.

State of KANSAS

County of BARTON

} ss:

I, VERNE A. MORRIS of GARVEY DRILLING COMPANY

upon oath state that the above and foregoing is a true and correct copy of the log of the #1 DAVIS "I" well.

Verne A. Morris

Subscribed and sworn to before me this 16th day of October 1959

My Commission Expires: April 14, 1963

Arthur J. Wiles
NOTARY PUBLIC