


STATE OF KANSAS
STATE CORPORATION COMMISSION

Give All Information Completely
Make Required Affidavit
Mail or Deliver Report to:
Conservation Division
State Corporation Commission
800 Bitting Building
Wichita, Kansas

15-007-01621-00-00
WELL PLUGGING RECORD

Barber County, Sec. 11 Twp. 33S Rge. 11W (E) (W)

Location as "NE/CNW/SW" or footage from lines NW SW SW
Lease Owner Orville H. Parker
Lease Name Davis Well No. 1
Office Address Box 791 - Ponca City, Oklahoma
Character of Well (completed as Oil, Gas or Dry Hole) Dry hole
Date well completed 5-10 19 55
Application for plugging filed 6-6 19 55
Application for plugging approved 6-1 19 55
Plugging commenced May 24 19 55
Plugging completed May 28 19 55
Reason for abandonment of well or producing formation Dry

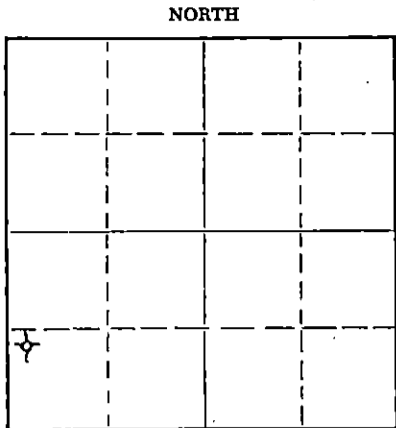

Locate well correctly on above Section Plat

If a producing well is abandoned, date of last production - 19 -
Was permission obtained from the Conservation Division or its agents before plugging was commenced? Yes

Name of Conservation Agent who supervised plugging of this well Merle Rives
Producing formation - Depth to top - Bottom - Total Depth of Well 4626 Feet
Show depth and thickness of all water, oil and gas formations.

OIL, GAS OR WATER RECORDS

CASING RECORD

FORMATION	CONTENT	FROM	TO	SIZE	PUT IN	PULLED OUT
Heebner		3597		8-5/8"	240'	None
Douglas	No Show	3714		5-1/2"	4625'	4035'
Lansing	No Show	3804				
Miss. ls	No Show	4492		Plugged hole back to 4564'		
Miss. Chat	Slight Show	4507		Casing perforated from 4510' to 4512'		

Describe in detail the manner in which the well was plugged, indicating where the mud fluid was placed and the method or methods used in introducing it into the hole. If cement or other plugs were used, state the character of same and depth placed, from _____ feet to _____ feet for each plug set.

Filled the hole with sand from 4564' to 4500' and ran 5 sacks of cement. Mudded the hole to 235', set a 10' rock bridge and ran 20 sacks of cement. Mudded the hole to 35', set a 10' rock bridge and ran 5 sacks of cement on top. Plugging completed.

DATE OF

6-10-55

(If additional description is necessary, use BACK of this sheet)

Name of Plugging Contractor West Supply Co., Inc.
Address Chase, Kansas

STATE OF Oklahoma, COUNTY OF Kay, ss.
Thalia Welborn (employee of owner) or (owner or operator) of the above-described well, being first duly sworn on oath, says: That I have knowledge of the facts, statements, and matters herein contained and the log of the above-described well as filed and that the same are true and correct. So help me God.

(Signature) Thalia Welborn
Box 791 Ponca City, Okla.
(Address)

SUBSCRIBED AND SWORN to before me this 6th day of June 19 55

Edward S. Greider
Notary Public.

My commission expires December 31, 1957

PLUGGING
FILE SEC 11 T 33R 11W
PAGE 123 LINE 29

DAVIS #1

Company - O. H. Parker
 Contractor - L. C. Smitherman Drilling Co.

Location: NW SW SW, Sec. 11-33S-11W,
 Barber County, Kansas.

Commenced - 3-23-55
 Completed - 4-6-55
 Total Depth - 4625'
 Initial Prod.

Elevation:
 Casing: 240' - 8 5/8" 4625' - 5 1/2"

Figures Indicate Bottom of Formations:

Depth	Formation
240 - 880	Shale Red rock & shells
880 - 1520	Shale & shells
1520 - 1690	Shale & lime
1690 - 1725	Lime & sand
1725 - 1790	Shale & shells
1790 - 2060	Lime
2060 - 2365	Lime & shale
2365 - 2500	Shale & lime
2500 - 2535	Shale
2535 - 2590	Lime
2590 - 2685	Lime & shale
2685 - 2990	Shale & lime
2990 - 3075	Lime w/sand
3075 - 3137	Lime
3137 - 3235	Lime & shale
3235 - 3380	Shale & lime
3380 - 3510	Lime & shale
3510 - 3605	Lime & sand
3605 - 3715	Shale & lime
3715 - 3745	Sand
3745 - 3800	Sand & shale
3800 - 4625	Lime

We hereby certify the above and foregoing to be a true and correct copy of the Log on the Davis #1, located NW SW SW, Section 11-33S-11W, of Barber County, Kansas.

L. C. SMITHERMAN DRILLING COMPANY

[Signature]

Subscribed and sworn to before me this 15th day of July, 1955.

[Signature]
 Notary Public

My commission expires October 23, 1958.

RECEIVED
 STATE CORPORATION COMMISSION

PLUGGING
 FILE SEC 11 T33 R 11W
 BOOK PAGE 123 LINE 19

Orville H. Parker - Davis #1 -- Day Work and Well Abandonment

DATE	PARKER TIME	REMARKS
5-24-55	10	Cleaned the cellar and bled gas off of the well.
5-25-55	11	Called out water trucks and ran water and sand in well to kill gas. Filled hole with sand from 4564' to 4500'. Loaded hole with water and closed well in with swage.
5-26-55	5	Checked in and found hole open. Ran 5 sacks of cement at 4500'. Shot casing at 4110' & 4006'. Worked casing loose and pulled 70 joints.
5-27-55	3	Pulled 5 joints of casing. Hooked up the pump and pumped in 15 sacks of mud. Pulled 50 joints of casing.
5-28-55	6	Mudded the hole to 235', set a 10' rock bridge and ran 20 sacks of cement. Mudded the hole to 35', set a 10' rock bridge and ran 5 sacks of cement on top.

Plugging completed

Well was plugged as per plugging instructions from State Plugger.