

STATE OF KANSAS
STATE CORPORATION COMMISSION
200 Colorado Derby Bldg.
Wichita, Kansas 67202

WELL PLUGGING RECORD

Give All Information Completely
Make Required Affidavit

COUNTY Kiowa SEC. 31 TWP. 27S RGE. 18 E/W
Location as in quarters or footage from lines:

X			
		31	

Lease Owner TGT Petroleum Corp.
 Lease Name Rice "D" Well No. 1-C
 Office Address 209 E. William - Wichita, Ks.
 Character of Well (Completed as Oil, Gas or Dry Hole): Core Hole
 Date Well Completed 11-3-82
 Application for plugging filed 11-3-82
 Plugging commenced 11-4-82 8:00 AM
 Plugging completed 11-4-82 8:30
 Reason for abandonment of well or producing formation Finish logging

Locate Well
correctly on above
Section Platt.

Was permission obtained from the Conservation Division or it's
Agent's before plugging was commenced? Yes

Name of Conservation Agent who supervised plugging of this well Bob Tarbutton
Producing formation _____ Depth to top _____ bottom _____ T.D. 1220

Show depth and thickness of all water, oil and gas formations.

OIL, GAS OR WATER RECORDS Casing Record

Formation	Content	From	To	Size	Put in	Pulled Out
	Surface Casing			5 1/2"	214'	Cemented

Describe in detail the manner in which the well was plugged, indicating where the mud fluid was placed and the method or methods used in introducing it into the hold. If cement or other plugs were used, state the character of same and depth placed, from _____ feet to _____ feet for each plug set.


Halliburton hook up to 5 1/2" surface casing. Mix & pump in 2 sacks gel, 2 sacks hulls on top of 40 visc. mud, followed by 65 sacks common cement, 2% gel, 3% cc. Then pump in 1/2 bbl. water to clear valve, swedge & landing sub. Pump in pressure start at 300 PSI, shut in at 150 PSI - leaving cement plug 15' to 750'.

(If additional description is necessary, use BACK of this sheet)

Name of Plugging Contractor TGT Petroleum Corp.

STATE OF Kansas COUNTY OF Sedgwick, ss.

B. Lynn Herrington (employee of owner) or (owner or operator) of the above-described well, being first duly sworn on oath, says: That I have knowledge of the facts, statements, and matters herein contained and the log of the above-described well as filed and that the same are true and correct. So help me God.

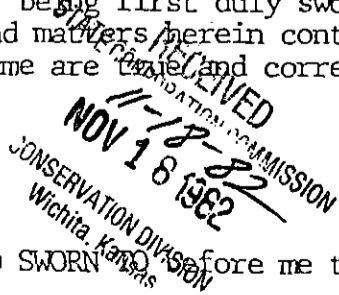

(Signature) B. Lynn Herrington
209 E. William - Wichita, Ks.
(Address)

SUBSCRIBED AND SWORN before me this 16th day of Nov., 1982

Judith K. Moser
Judith K. Moser Notary Public.

My Commission expires: 5-17-85

