


- WELL PLUGGING RECORD

Give All Information Completely
Make Required Affidavit
Mail or Deliver Report to:
Conservation Division
State Corporation Commission
211 No. Broadway
Wichita, Kansas

Pratt County, Sec. 31 Twp. 27 Rge. 13 (E) (W)

Location as "NE/CNW/SW" or footage from lines S¹/₂ S²/₂ S³/₂
Lease Owner H. C. Bennett
Lease Name Elliott A Well No. 3
Office Address 1212 United National Bldg., Wichita, Kansas
Character of Well (completed as Oil, Gas or Dry Hole) oil well
Date well completed 6-2-55 19
Application for plugging filed 6-1-65 19
Application for plugging approved 6-3-65 19
Plugging commenced 7-2-65 19
Plugging completed 7-15-65 19
Reason for abandonment of well or producing formation depleted

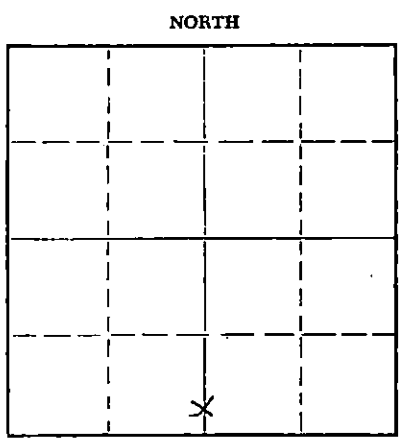

Locate well correctly on above Section Plat

If a producing well is abandoned, date of last production _____ 19____
Was permission obtained from the Conservation Division or its agents before plugging was commenced? yes

Name of Conservation Agent who supervised plugging of this well Archie Flying
Producing formation _____ Depth to top _____ Bottom _____ Total Depth of Well 4475 Feet
Show depth and thickness of all water, oil and gas formations.

OIL, GAS OR WATER RECORDS

CASING RECORD

FORMATION	CONTENT	FROM	TO	SIZE	PUT IN	PULLED OUT
				8 5/8	359	none
				5 1/2	4472	2390.82

Describe in detail the manner in which the well was plugged, indicating where the mud fluid was placed and the method or methods used in introducing it into the hole. If cement or other plugs were used, state the character of same and depth placed, from _____ feet to _____ feet for each plug set.

Fill hole with chat from 4442' to 4390' and dump 5 sacks cement.
Set 10' rock bridge from 290' to 280' and dump 4 sacks cement.
Let set and bailed hole dry. Dumped 23 sacks cement. Mud hole to 40'. Set 10' rock bridge and dumped 10 sacks cement to surface.

RECEIVED
STATE CORPORATION COMMISSION
7-27-65
JUL 27 1965

CONSERVATION DIVISION
Wichita, Kansas

Name of Plugging Contractor Flint Engineering & Construction Company
Address Box 950, El Dorado, Kansas

STATE OF KANSAS COUNTY OF BUTLER, ss.

_____, (employee of owner) or (owner or operator) of the above-described well, being first duly sworn on oath, says: That I have knowledge of the facts, statements, and matters herein contained and the log of the above-described well as filed and that the same are true and correct. So help me God.

(Signature) Gauss Bawelle
El Dorado, Kansas
(Address)

SUBSCRIBED AND SWORN TO before me this 20th day of July, 19 65

My commission expires 9-27-67
Ronald R. Hanson Notary Public.

WELL LOG BUREAU—KANSAS GEOLOGICAL SOCIETY
503 East Murdock, Wichita, Kansas

COPY


Company: STERLING DRILLING CO. & C. F. HERTLEIN
Farm: Elliott "A" No. 3

SEC. 31 T. 27 R. 13W
S/2 S/2 E/2

Total Depth. 4475 PBD 4460
Comm. 4-23-55 Comp. 6-2-55
Shot or Treated.
Contractor, Sterling Drilling Co.
Issued. 8-13-55

County Pratt

KANSAS

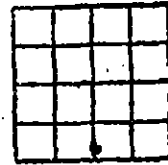

Elevation. 1913 RB

Production 1847 BOPD

CASING:

8 5/8 @ 359' w/ 225 sx cmt.
5 1/2 @ 4472' w/ 150 sx cmt.

Figures indicate Bottom of Formations.

sand & shale	360
shale & red bed	750
anhydrite	775
red bed & shale	1020
shale & shells	1815
lime	1925
shale & lime	2070
lime	2285
lime & shale	3445
lime	3665
lime & shale	3810
lime	4240
shale & lime	4300
shale & Viola chert	4335
lime	4375
shale & sand	4465
shale & lime	4475
Total Depth	Plug back to 4460'

SCOUT TOPS:

Heebner	3645
Brown lime	3805
Lansing	3818
Mississippi	4275
Viola	4315
Simpson	4403

MICT, Drld cmt. to PBD 4460' perf
4399-4406, bailed 5 GW after 30 min.
Acid. w/ 500 gal. MCA, fraced w/
100 bbls. hvy crude & 4500# sand. ran
tbg. swbd. 18 bbls load oil & well
kicked off flowing @ rate 17 BOPH
for 5 hrs.

RECEIVED
STATE CORPORATION COMMISSION
JUL 27 1965
CONSERVATION DIVISION
Wichita, Kansas