


STATE OF KANSAS
STATE CORPORATION COMMISSION

Give All Information Completely
Make Required Affidavit
Mail or Deliver Report to:
Conservation Division
State Corporation Commission
211 No. Broadway
Wichita, Kansas

WELL PLUGGING RECORD

Pratt County. Sec. 10 Twp. 27S Rge. 15(W)
Location as "NE/CNW/SW" or footage from lines NE-NE-SW
Lease Owner Tidewater Oil Company
Lease Name Sue K. Cochran Well No. 1
Office Address Box 157 - Reece, Kansas
Character of Well (completed as Oil, Gas or Dry Hole) Oil
Date well completed 12-28 1956
Application for plugging filed 8-14 1959
Application for plugging approved 8-17 1959
Plugging commenced 9-1 1959
Plugging completed 9-6 1959
Reason for abandonment of well or producing formation Did Not Produce

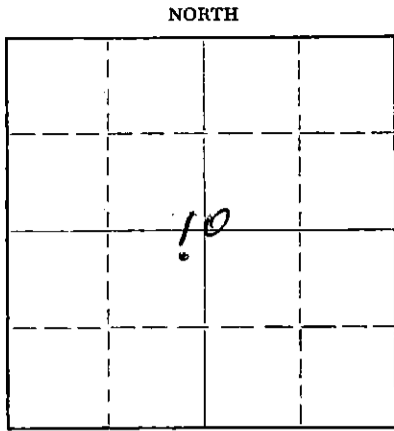

Locate well correctly on above
Section Plat

If a producing well is abandoned, date of last production 19
Was permission obtained from the Conservation Division or its agents before plugging was commenced? Yes

Name of Conservation Agent who supervised plugging of this well Fred Hampel
Producing formation Cherokee Depth to top 4392 Bottom 4396 Total Depth of Well 4439 Feet
Show depth and thickness of all water, oil and gas formations.

OIL, GAS OR WATER RECORDS

CASING RECORD

| FORMATION | CONTENT | FROM | TO | SIZE | PUT IN | PULLED OUT |
|-----------|---------|------|----|--------|--------|------------|
| | | | | 5 1/2" | 4439' | 3780.06' |
| | | | | 8 5/8" | 326' | |
| | | | | | | |
| | | | | | | |
| | | | | | | |
| | | | | | | |

Describe in detail the manner in which the well was plugged, indicating where the mud fluid was placed and the method or methods used in introducing it into the hole. If cement or other plugs were used, state the character of same and depth placed, from feet to feet for each plug set.

Plugged well Back from 4439' to 4370' with sand and gravel.
Dumped 5 sacks cement on bottom at 4370'
Dumped rotary pit mud to 260'
Set 10' rock bridge at 260' and dumped 20 sacks cement, wet.
Set 5' rock bridge at 35' and dumped 10 sacks cement.
Filled hole to 3' below surface.
Cut off 8 5/8" Surface pipe at 3' and welded on steel cap.

(If additional description is necessary, use BACK of this sheet)
Name of Plugging Contractor Kent Well Servicing Company
Address Box 667 - El Dorado, Kansas

STATE OF Kansas, COUNTY OF Butler, ss.
(employee of owner) or (owner or operator) of the above-described well, being first duly sworn on oath, says: That I have knowledge of the facts, statements, and matters herein contained and the log of the above-described well as filed and that the same are true and correct. So help me God.

(Signature) Merle B. Drum

SUBSCRIBED AND SWORN TO before me this 10th day of September, 1959

(Address) Exhelene E. Phillips
Notary Public.

My commission expires Jan 18, 1963

PLUGGING
FILE SEC 10 T 27 R 15W
BOOK PAGE 60 LINE 15

RECEIVED
STATE CORPORATION COMMISSION

SEP 11 1959

CONSERVATION DIVISION
Wichita