

STATE OF KANSAS
STATE CORPORATION COMMISSION


Form CP-4

Give All Information Completely
Make Required Affidavit
Mail or Deliver Report to:
Conservation Division
State Corporation Commission
P. O. Box 17027
Wichita, Kansas 67217
NORTH

WELL PLUGGING RECORD

Pratt County. Sec. 10 Twp. 27S Rge. 15W (E) (W) XX

Location as "NE/CNW/SW" or footage from lines NE NE SW
Lease Owner Publishers Petroleum
Lease Name # 1 Newby Well No. 1
Office Address Box 25125, Oklahoma City, Oklahoma 67312
Character of Well (completed as Oil, Gas or Dry Hole) D & A
Date well completed November 29 19 73
Application for plugging filed November 29 19 73
Application for plugging approved November 29 19 73
Plugging commenced November 29 19 73
Plugging completed November 29 19 73
Reason for abandonment of well or producing formation D & A

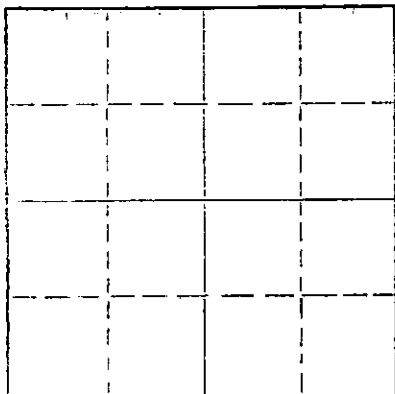

Locate well correctly on above
Section Plat

If a producing well is abandoned, date of last production _____ 19____
Was permission obtained from the Conservation Division or its agents before plugging was commenced? Yes

Name of Conservation Agent who supervised plugging of this well G. R. Biberstein
Producing formation _____ Depth to top _____ Bottom _____ Total Depth of Well 3390 Feet
Show depth and thickness of all water, oil and gas formations.

OIL, GAS OR WATER RECORDS

CASING RECORD

FORMATION	CONTENT	FROM	TO	SIZE	PUT IN	PULLED OUT
				8-5/8	361'	-0-

Describe in detail the manner in which the well was plugged, indicating where the mud fluid was placed and the method or methods used in introducing it into the hole. If cement or other plugs were used, state the character of same and depth placed, from _____ feet to _____ feet for each plug set.

50 sx cement @ 500'
25 sx @ 340'
Plug 1/2 sx Halls
10 sx cement to Bottom

RECEIVED
STATE CORPORATION COMMISSION
DEC 12 1973
CONSERVATION DIVISION
Wichita, Kansas

(If additional description is necessary, use BACK of this sheet)
Name of Plugging Contractor Red Tiger Drilling Company
Address 1720 Wichita Plaza, Wichita, Kansas 67202

STATE OF Kansas COUNTY OF Sedgwick, ss.
Dann Brennan (employee of owner) or (owner or operator) of the above-described

well, being sworn on oath, says: That I have knowledge of the facts, statements, and matters herein contained and the log of the above-described well as filed and that the same are true and correct. So help me God.

(Signature) Dann Brennan
1720 Wichita Plaza, Wichita, Ks 67202
(Address)

SUBSCRIBED AND SWORN TO before me this 5 day of December, 19 73

My commission expires 3-8-77
Linda W. Dickens
Notary Public.

DRILLERS LOG

Newby

CASING RECORD:

8-5/8" @ 361'
w/350 sx cement

TOTAL DEPTH: 3390'

COMPANY: Publishers Petroleum

CONTRACTOR: Red Tiger Drilling

COMMENCED: November 21, 1973

COMPLETED: November 29, 1973

DESCRIPTION:

NE NE SW
10-27S-15W
Pratt County
Kansas

ELEVATION:

FORMATION	FROM	TO
Sand	0	362
Shale	362	997
Anhydrite	997	1018
Shale	1018	1701
Shale & Lime	1701	2040
Lime	2040	2530
Lime & Shale	2530	3274
Lime	3274	3390

REMARKS
 RECEIVED
 STATE CORPORATION COMMISSION
 DEC 12 1973
 CONSERVATION DIVISION
 Wichita, Kansas

I certify that this is a true and correct copy of the above log to the best of my knowledge.

RED TIGER DRILLING COMPANY

D. Ann Drennan
D. Ann Drennan

Subscribed and sworn to before me this 5th day of December, 1973.

Linda W. Dickens
Notary Public

My Commission Expires:

3-8-77

