


STATE OF KANSAS
STATE CORPORATION COMMISSION

Give All Information Completely
Make Required Affidavit
Mail or Deliver Report to:
Conservation Division
State Corporation Commission
800 Bitting Building
Wichita, Kansas

WELL PLUGGING RECORD

NORTH

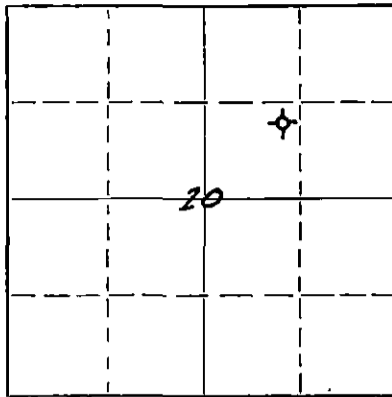

Locate well correctly on above
Section Plat

Pratt County. Sec. 10 Twp. 27 Rge. 15 (E) W (W)
Location as "NE/CNW/SW" or footage from lines NE-SW-NE
Lease Owner D. R. Lauck Oil Co., Inc.
Lease Name Cochran Well No. 1
Office Address 501 So. Broadway, Wichita, Kansas
Character of Well (completed as Oil, Gas or Dry Hole) Dry
Date well completed May 15 19 57
Application for plugging filed May 15 19 57
Application for plugging approved May 20 19 57
Plugging commenced May 31 19 57
Plugging completed June 5 19 57
Reason for abandonment of well or producing formation Dry

If a producing well is abandoned, date of last production None 19
Was permission obtained from the Conservation Division or its agents before plugging was commenced? Yes

Name of Conservation Agent who supervised plugging of this well M. A. Rives
Producing formation Conglomerate Depth to top 4386 Bottom 4397 Total Depth of Well 4440 Feet
Show depth and thickness of all water, oil and gas formations.

OIL, GAS OR WATER RECORDS

CASING RECORD

FORMATION	CONTENT	FROM	TO	SIZE	PUT IN	PULLED OUT
Conglomerate	Dry			8 5/8"	285'	None
				5 1/2"	4440'	3639'

Describe in detail the manner in which the well was plugged, indicating where the mud fluid was placed and the method or methods used in introducing it into the hole. If cement or other plugs were used, state the character of same and depth placed, from _____ feet to _____ feet for each plug set.

Cement 4440-4409' Did not drill cement out of shoe joint.
 Sand 4409-4340'
 Cement 4340-4310' 5 Sx
 Mud 4310- 275'
 Rock 275- 265'
 Cement 265- 205' 20 Sy
 Mud 205- 30'
 Cement 30' to cellar 10 Sy

(If additional description is necessary, use BACK of this sheet)

Name of Plugging Contractor R & S Pipe Pulling Co.
Address Box 192, Ellinwood, Kansas

STATE OF _____, COUNTY OF _____, ss.

(employee of owner) or (owner or operator) of the above-described well, being first duly sworn on oath, says: That I have knowledge of the facts, statements, and matters herein contained and the log of the above-described well as filed and that the same are true and correct. So help me God.

(Signature) [Signature]
Box 47, Ellinwood, Kansas
(Address)

SUBSCRIBED AND SWORN TO before me this 10 day of June, 19 57

My commission expires Sept. 14, 1959

24-2675-5 2-52-20M

PLUGGING
FILE SEC 10 T 27 R 15W
BOOK PAGE 13 LINE 12

RECEIVED
STATE CORPORATION COMMISSION
6-11-57
JUN 11 1957
CONSERVATION DIVISION
Wichita, Kansas

D. R. Lauck Oil Company, Inc.
and. Sunray Mid-Continent Oil Company

Cochran #1

NE SW NE Sec.10-27S-15W
Pratt County, Kansas

Commenced Rotary: April 25, 1957
Completed Rotary: May 9, 1957
Completed Completion: May 15, 1957

Casing Record: 285 feet 8 5/8" cemented w/250 sax
4440 feet 5 1/2" " " 100 sax

Elevation: GR 2048; DF 2051; KB 2053;

Drillers Log

		Sample	Tops Halliburton
Shale & sand	50	Heebner 3777-1724	3776-1723
sand	210	Douglas 3817-1764	3818-1765
shale & red bed	285	Brown Lime 3931-1878	3932-1879
red bed	560	Lansing 3951-1898	3952-1899
sand	720	Base Kansas C. 4276-2223	4276-2223
red bed	910	Sandy Conglom. 4390-2337	4386-2333
sand & red bed	995	Mississippian 4410-2357	4408-2355
Anhydrite	1020	Kinderhook 4427-2374	4426-2373
shale & shells	1955	Rotary Total	
Lime & shale	2030	Depth 4440-2387	4441-2388
Lime (Broken)	2215		
Lime	2345	DST #1 (M-D) 4379-4407, open 1 hour;	
Lime & shale	2485	strong blow throughout test;	
Broken Lime	2550	gas to surface in 5 min.	
shale & lime	2865	Gauge 1,140,000 CFS recovered	
shale & shells	3100	80' gas-cut mud. IFP 205#;	
shale & Lime	3280	FFP 205#; BHP 1400# in 20 min.	
Lime & shale	3465		
Lime	3766	After perforating 88 shots	
Lime & shale	3930	4384-4397 & frac.	
Lime	4397	D & A	
shale & chert	4414		
Lime	4440		

PLUGGING
FILE SEC. 10 T. 27 R. 15W
BOOK PAGE 13 LINE 12

RECEIVED
STATE CONSERVATION COMMISSION

MAY 17 1957

CONSERVATION DIVISION
Wichita, Kansas