

STATE OF KANSAS  
STATE CORPORATION COMMISSION


WELL PLUGGING RECORD

Give All Information Completely  
Make Required Affidavit  
Mail or Deliver Report to:  
Conservation Division  
State Corporation Commission  
800 Bitting Building  
Wichita, Kansas

Pratt

County. Sec. 27 Tw 27 Rge 14 (E) (W)

NORTH

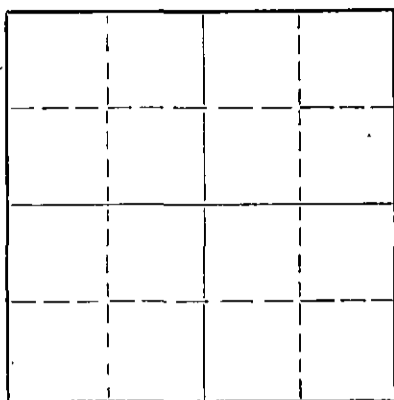

Locate well correctly on above  
Section Plat

Location as "NE/CNW/SW" or footage from lines. NE NE NW  
Lease Owner Musgrove Petroleum Corporation  
Lease Name Reed Well No. 1  
Office Address 518 Petroleum Building, Wichita, Kansas  
Character of Well (completed as Oil, Gas or Dry Hole) Dry hole  
Date well completed April 28, 19 53  
Application for plugging filed April 28, 19 53  
Application for plugging approved \_\_\_\_\_ 19 \_\_\_\_\_  
Plugging commenced April 28, 19 53  
Plugging completed \_\_\_\_\_ 19 \_\_\_\_\_  
Reason for abandonment of well or producing formation Dry hole

If a producing well is abandoned, date of last production \_\_\_\_\_ 19 \_\_\_\_\_  
Was permission obtained from the Conservation Division or its agents before plugging was commenced? Yes

Name of Conservation Agent who supervised plugging of this well \_\_\_\_\_  
Producing formation \_\_\_\_\_ Depth to top \_\_\_\_\_ Bottom \_\_\_\_\_ Total Depth of Well 4674 Feet  
Show depth and thickness of all water, oil and gas formations.

OIL, GAS OR WATER RECORDS

CASING RECORD

FORMATION	CONTENT	FROM	TO	SIZE	PUT IN	PULLED OUT
				8-5/8"	393.67'	

Describe in detail the manner in which the well was plugged, indicating where the mud fluid was placed and the method or methods used in introducing it into the hole. If cement or other plugs were used, state the character of same and depth placed, from \_\_\_\_\_ feet to \_\_\_\_\_ feet for each plug set.

Plugged hole - first plug at 270' with 20 sacks cement.  
second plug at 35' with 10 sacks cement.

RECEIVED  
CORPORATION COMMISSION  
MAY 5 1953  
CONSERVATION DIVISION  
KANSAS

(If additional description is necessary, use BACK of this sheet)  
Name of Plugging Contractor Musgrove Petroleum Corporation,  
Address 518 Petroleum Building, Wichita, Kansas

STATE OF Kansas, COUNTY OF Sedgwick, ss.  
Gordon L. Koelling (employee of owner) or (owner or operator) of the above-described well, being first duly sworn on oath, says: That I have knowledge of the facts, statements, and matters herein contained and the log of the above-described well as filed and that the same are true and correct. So help me God.

(Signature) Gordon L. Koelling  
518 Petroleum Building, Wichita, Kansas.  
(Address)

SUBSCRIBED AND SWORN to before me this 6th day of May, 19 53

Thomas S. Stinson  
Notary Public.

My commission expires Sept. 24, 1956.

PLUGGING  
FILE SEC 27 T 27 R 14 W  
BOOK PAGE 28 USE 11

CONTRACTOR'S WELL LOG

COMPANY: Musgrove Petroleum Corporation  
 CONTRACTOR: Musgrove Petroleum Corporation  
 FARM: Reed #1  
 LOCATION: NE NE NW Section 27-27-14  
 Pratt County, Kansas  
 COMMENCED: April 3, 1953  
 COMPLETED: April 28, 1953

0	130	Sand
130	275	Shale, shell & sand
275	305	Red bed & shale
305	385	Red bed & sand
385	730	Red bed, sand & shale
730	852	Red bed, shale
852	870	Anhydrite
870	880	Shale & shells
880	1920	Red bed, shale & shells
1920	3490	Lime & shale
3490	3835	Lime
3835	3871	Lime & shale
3871	4374	Lime
4374	4387	Mississippi lime & chert
4387	4576	Lime & chert
4576	4674	Arbuckle
	4674	Total Rotary Depth

Set 8-5/8" at 393.67' with 300 sacks of cement.

Dry and abandoned.

STATE OF KANSAS }  
 COUNTY OF SEDGWICK } SS

I, GORDON L. KOELLING, do hereby certify that the above and foregoing is a true and correct copy of the log of the Reed #1 Sec. 27-27-14, Pratt County, Kansas, as reflected by the files of the Musgrove Petroleum Corporation.

RECEIVED  
 OIL CORPORATION COMMISSION  
 MAY - 7 1953  
 CONSERVATION DIVISION  
 WICHITA, KANSAS

MUSGROVE PETROLEUM CORPORATION

By Gordon L. Koelling  
 Secretary-Treasurer

Subscribed and sworn to before me, a Notary Public in and for Sedgwick County, Kansas, this 5th day of May, 1953.

Thomas L. Stinson  
 Notary Public

My commission expires: Sept. 24, 1956.

**PLUGGING**  
 FILE SEC 27-27-14W  
 BOOK PAGE 28 LINE 17