

STATE OF KANSAS
STATE CORPORATION COMMISSION


WELL PLUGGING RECORD

Give All Information Completely
Make Required Affidavit
Mail or Deliver Report to:
Conservation Division
State Corporation Commission
800 Blitting Building
Wichita, Kansas

OR

FORMATION PLUGGING RECORD

Strike out upper line
when reporting plugging
off formations.

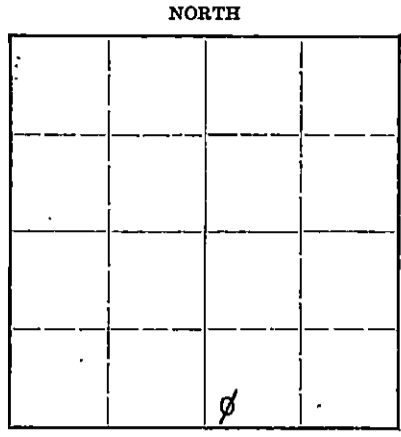

Locate well correctly on above
Section Flat


Pratt County. Sec. 27 Twp. 27S Rge. X20X14 (W)
Location as "NE $\frac{1}{4}$ NW $\frac{1}{4}$ SW $\frac{1}{4}$ " or footage from lines SW SW SE $\frac{1}{4}$
Lease Owner W. C. McBride, Inc., Derby Oil Co., E. K. Carsey, Contractor
Lease Name E. L. McBride Well No. 1
Office Address 2101 Missouri Pacific Building, St. Louis, Mo.
Character of Well (completed as Oil, Gas or Dry Hole) Dry Hole
Date well completed 11/11/47 19...
Application for plugging filed 11/13/47 19...
Application for plugging approved... 19...
Plugging commenced 11/11/47 19...
Plugging completed 11/11/47 19...
Reason for abandonment of well or producing formation Dry Hole

If a producing well is abandoned, date of last production... 19...
Was permission obtained from the Conservation Division or its agents before plugging was commenced? Yes

Name of Conservation Agent who supervised plugging of this well H. W. Kerr
Producing formation... Depth to top... Bottom... Total Depth of Well 4667 Feet
Show depth and thickness of all water, oil and gas formations.

OIL, GAS OR WATER RECORDS				CASING RECORD		
Formation	Content	From	To	Size	Put In	Pulled Out
<u>Arbuckle Lime</u>	<u>Dry</u>	<u>4577</u>	<u>4667</u>	<u>8 5/8</u>	<u>817</u>	<u>None</u>

Describe in detail the manner in which the well was plugged, indicating where the mud fluid was placed and the method or methods used in introducing it into the hold. If cement or other plugs were used, state the character of same and depth placed, from... feet to... feet for each plug set.
4667 to 820 mud. Hold bridged 820 - 15 sacks cement. Mud to 250'.
Hole bridged 10 sacks cement. Mud to base of cellar. 6 sacks cement
top of surface at base of cellar.

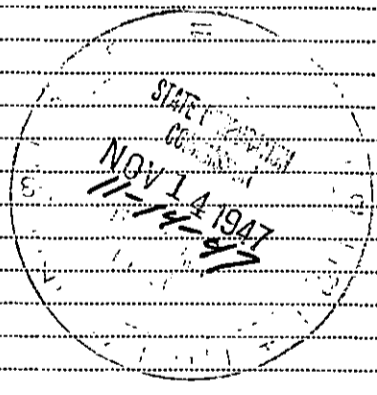

(If additional description is necessary, use BACK of this sheet)
Correspondence regarding this well should be addressed to W. C. McBride, Inc.
Address Box 433, McPherson, Kansas

STATE OF KANSAS, COUNTY OF MCPHERSON, ss.
FRANK ZIMMERMAN (employee of owner) or (owner or operator) of the above-described well,
being first duly sworn on oath, says: That I have knowledge of the facts, statements, and matters herein contained and the log of the above-described well as filed and that the same are true and correct. So help me God

(Signature) [Signature]
Box 433, McPherson, Kansas
(Address)

SUBSCRIBED AND SWORN to before me this 13th day of November, 1947.
David Paoli
Notary Public.

My commission expires July 15, 1951

PLUGGING
FILE SEC 27 T 27 R 14 W
BOOK PAGE 136 LINE 44

FORMATION RECORD, Cont'd.

Depth from	To	Feet	Formation
3320	3385		Lime
3385	3520		Lime & Shale
3520	3585		Lime
3585	3885		Lime & Shale
3885	4257		Lime
4257	4307		Conglomerate
4307	4502		Lime & Chert
4502	4576		Shale & Lime
4576	4667		Lime
4667			T.D. D. & A.

Drillers Log

 NOV 14 1947

PLACING
 FILE SEC 27-27-140
 BOOK PAGE 46 LINE 24