


STATE OF KANSAS  
STATE CORPORATION COMMISSION

Give All Information Completely  
Make Required Affidavit  
Mail or Deliver Report to:  
Conservation Division  
State Corporation Commission  
800 Bittling Building  
Wichita, Kansas

WELL PLUGGING RECORD

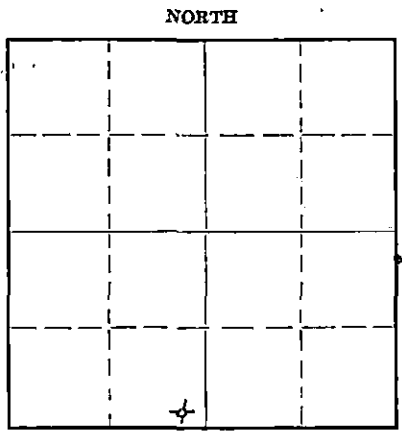

Locate well correctly on above  
Section Plat

Barber County. Sec. 35 Twp. 27S Rge. (E) 13 (W)  
Location as "NE/CNW 1/4 SW 1/4" or footage from lines SE SE SW  
Lease Owner White Eagle Oil Company  
Lease Name Warren Well No. 1  
Office Address 415 Philtower, Tulsa, Oklahoma  
Character of Well (completed as Oil, Gas or Dry Hole)  
Date well completed March 21 19 49  
Application for plugging filed March 21 19 49  
Application for plugging approved March 21 19 49  
Plugging commenced March 21 19 49  
Plugging completed March 21 19 49  
Reason for abandonment of well or producing formation Lost Hole. Skidded Rig

If a producing well is abandoned, date of last production 19  
Was permission obtained from the Conservation Division or its agents before plugging was commenced? Yes

Name of Conservation Agent who supervised plugging of this well C. D. Stough  
Producing formation Depth to top Bottom Total Depth of Well 333 Feet  
Show depth and thickness of all water, oil and gas formations.

OIL, GAS OR WATER RECORDS

CASING RECORD

Formation	Content	From	To	Size	Put In	Pulled Out

Describe in detail the manner in which the well was plugged, indicating where the mud fluid was placed and the method or methods used in introducing it into the hole. If cement or other plugs were used, state the character of same and depth placed, from feet to feet for each plug set.

333' - 71 1/2' - Heavy Rotary Mud  
71 1/2' - 70' - Wooden Plug  
70' - 6' - 70 sks cement by Halliburton  
6' - surface - cellar

REC 3-21-49


(If additional description is necessary, use BACK of this sheet)  
Correspondence regarding this well should be addressed to White Eagle Oil Company  
Address 415 Philtower Building  
Tulsa, Oklahoma

STATE OF Kansas, COUNTY OF Barton, ss.  
Glenn Peel Drilling Company, Inc. (employee of owner) or (owner or operator) of the above-described well,  
being first duly sworn on oath, says: That I have knowledge of the facts, statements, and matters herein contained and the log of the above-described well as filed and that the same are true and correct. So help me God. GLENN PEEL DRILLING COMPANY, INC.  
(Signature) BY: [Signature]  
P.O. Box 359, Hoisington, Kansas (Address)

SUBSCRIBED AND SWORN to before me this 25th day of March, 19 49

Marion M. Herkel  
Notary Public.

My commission expires June 4, 1951

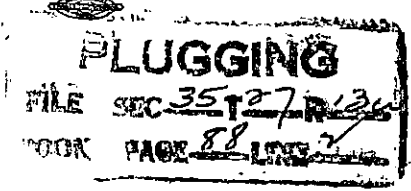

DRILLER'S LOG

Company: White Eagle Oil Company

Sec. 35 Twp. 27S Rge. 13W  
SE SE SW

Farm: Warren Well No. 1

Total Depth: 333' (Rotary)

County: Barber

Comm.: 3-17-49 Comp.: 3-21-49

Kansas

Contractor: Glenn Peel Drilling Co., Inc.

Casing:

Elevation:

None

Production:

Figures below indicate bottom of formations

Sand	0 -	150
Sand & Shale		220
Shale		333
Total Depth (Rotary)		333

This is to certify that the above information is, to the best of our knowledge, true and correct.

GLENN PEEL DRILLING COMPANY, INC.

BY: J. B. Anderson

SUBSCRIBED AND SWORN to before me this 25th day of March, 1949

My commission expires June 4, 1951

Marian M. Hester  
Notary Public

