


STATE OF KANSAS
STATE CORPORATION COMMISSION

Form CP-4

Give All Information Completely
Make Required Affidavit
Mail or Deliver Report to:
Conservation Division
State Corporation Commission
212 No. Market
Wichita, Kansas 67202

WELL PLUGGING RECORD

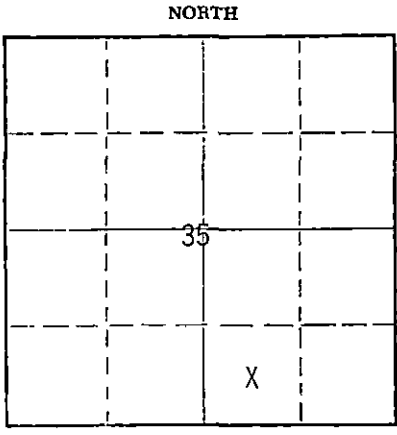

Locate well correctly on above Section Plat

Pratt County, Sec. 35 Twp. 27 Rge. 13W (E) (W)

Location as "NE/CNW/SW" or footage from lines XX/XX/XX C SW SE
Lease Owner Clinton Oil Company
Lease Name DeWayne Moore #1 Well No. _____
Office Address Wichita, Kansas 67202
Character of Well (completed as Oil, Gas or Dry Hole) Oil
Date well completed 12-15-68 19____
Application for plugging filed 7-08-71 19____
Application for plugging approved 7-08-71 19____
Plugging commenced 7/16/71 19____
Plugging completed 7/22/71 19____
Reason for abandonment of well or producing formation depleted.

If a producing well is abandoned, date of last production _____ 19____
Was permission obtained from the Conservation Division or its agents before plugging was commenced? yes

Name of Conservation Agent who supervised plugging of this well Biberstein
Producing formation Simpson Sand Depth to top 4351 Bottom 4356 Total Depth of Well 4385' Feet
Show depth and thickness of all water, oil and gas formations.

OIL, GAS OR WATER RECORDS

CASING RECORD

FORMATION	CONTENT	FROM	TO	SIZE	PUT IN	PULLED OUT
				13-3/8	196	none
				5 1/2"	4384'	2919'

Describe in detail the manner in which the well was plugged, indicating where the mud fluid was placed and the method or methods used in introducing it into the hole. If cement or other plugs were used, state the character of same and depth placed, from _____ feet to _____ feet for each plug set.

Sanded hole to 4340', loaded hole with water and set 5 sacks of cement. Shot pipe at 3313', 3220', 3126', 3031', 2934', pulled 8 joints and well blew in, put orbit valve on 5 1/2" and closed well in. Tried to blow well down, pumped salt water to kill well, pulled 90 joints of 5 1/2" casing. Bailed hole to 160' and set 20' rock bridge and ran 5 yards ready mix.

PLUGGING COMPLETE.

RECEIVED
STATE CORPORATION COMMISSION
AUG 6 1971
CONSERVATION DIVISION
Wichita, Kansas

(If additional description is necessary, use BACK of this sheet)
Name of Plugging Contractor KNIGHT CASING PULLING CO., INC.
Address CHASE, KANSAS

STATE OF KANSAS, COUNTY OF RICE, ss.
NOEL J. KNIGHT (employee of owner) or (owner or operator) of the above-described well, being first duly sworn on oath, says: That I have knowledge of the facts, statements, and matters herein contained and the log of the above-described well as filed and that the same are true and correct. So help me God.

(Signature) Noel Knight
CHASE, KANSAS
(Address)

SUBSCRIBED AND SWORN TO before me this 27 day of July, 19 71



MARJARET MELCHER
NOTARY PUBLIC
Rice County, Kansas
My Commission Expires
Feb. 15, 1975

Marjaret Melcher
Notary Public.

WELL LOG

SP

COMPANY Clinton Oil Company
FARM Moore NO. 1-V

SEC. 35 T. 27S R. 13W

LOG. SE SW SE


TOTAL DEPTH 4385'

COUNTY Pratt Co., Kansas

COMM. 12-3-68 COMP. 12-15-68

CONTRACTOR Garvey Drilling Company

CASING 13 3/8" @ 196' w/325 sx
5 1/2" @ 4384' w/125 sx

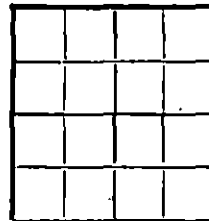

ELEVATION

PRODUCTION

FIGURES INDICATE BOTTOM OF FORMATIONS

- 25' Clay
- 144' Sand
- 196' Red Bed
- 698' Red Bed & Shale
- 698' Anhydrite
- 745' Shale & Red Bed
- 1976' Shale & Shells
- 3847' Lime & Shale
- 4224' Lime
- 4269' Lime & Chert
- 4320' Lime
- 4385' Sand
- 4385' RTD

State of Kansas }
County of Barton } SS

I, Eunice McEachern of Garvey Drilling Company

upon oath state the above and foregoing is a true and correct copy of the log of the Moore 1-V well.

Eunice McEachern

Subscribed and sworn to before me this 20 day of December 19 68

My Commission Expires: November 5th, 1969

Richard L. Boyer
NOTARY PUBLIC