


STATE OF KANSAS
STATE CORPORATION COMMISSION

WELL PLUGGING RECORD

Give All Information Completely
Make Required Affidavit
Mail or Deliver Report to
Conservation Division
State Corporation Comm.
245 North Water
Wichita, KS 67202

Kiowa County. Sec. 12 Twp. 27S Rge. 17W E/W
Location as "NE/CNW 1/4 SW 1/4" or footage from lines
1980' FNL and 1320' FEL
Lease Owner Texas Oil & Gas Corp.
Lease Name Clark "C" Well No. 1
Office Address 200 W. Douglas, Suite 300, Wichita
Character of Well (Completed as Oil, Gas or Dry Hole) Dry Hole
Date Well completed May 23, 1977
Application for plugging filed Verbal Application 19__
Application for plugging approved Verbal Approval 19__
Plugging commenced May 23, 1977
Plugging completed May 23, 1977
Reason for abandonment of well or producing formation _____

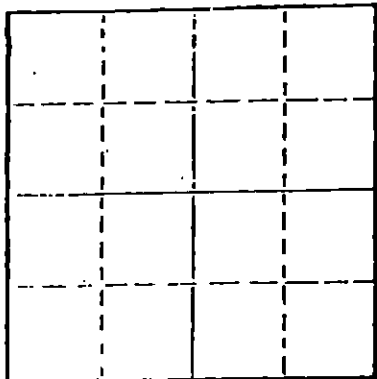

Locate well correctly on above
Section Plat

If a producing well is abandoned, date of last production 19__

Was permission obtained from the Conservation Division or its agents before plugging was commenced? Yes

Name of Conservation Agent who supervised plugging of this well Buddy Metz
Producing formation _____ Depth to top _____ Bottom _____ Total Depth of Well _____
Show depth and thickness of all water, oil and gas formations.

OIL, GAS OR WATER RECORDS

CASING RECORD

FORMATION	CONTENT	FROM	TO	SIZE	PUT IN	PULLED OUT
				8-5/8"	429'	NONE

Describe in detail the manner in which the well was plugged, indicating where the mud fluid was placed and the method or methods used in introducing it into the hold. If cement or other plugs were used, state the character of same and depth placed, from _____ feet to _____ feet for each plug set.

Filled hole with heavy rotary mud from 4,710 ft. (rotary total depth) to 420 ft. Set plug at 420 ft. and cemented with 35 sacks cement.
Filled hole with heavy rotary mud from 420 ft. to 40 ft. Set solid plug at 40 ft. and cemented to cellar with 12 sacks cement, 5 sacks cement in rat hole.

Plugging operations accomplished utilizing Halliburton Services Oil Well cementing pump truck through 4 1/2 inch drill pipe.

(If additional description is necessary, use BACK of this sheet)


Name of Plugging Contractor _____

STATE OF Kansas COUNTY OF Sedgwick, ss.
Dean Britting, Agent (Signature of owner) ~~XXXXXXXXXXXXXXXXXXXX~~

of the above-described well, being first duly sworn on oath, says: That I have knowledge of the facts, statements, and matters herein contained and the log of the above-described well as filed and that the same are true and correct. So help me God.

(Signature) Dean Britting
200 N. Main, Wichita, Kansas 67202
(Address)

SUBSCRIBED AND SWORN TO before me this 27th day of May, 1977

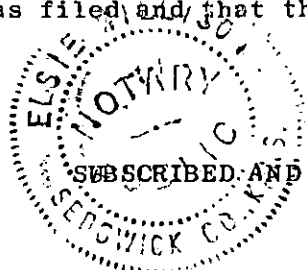

Elsie Willison RECEIVED
STATE CORPORATION COMMISSION
Notary Public.

My commission expires June 30, 1978

MAY 31 1977

CONSERVATION DIVISION
Wichita, Kansas

5-31-77

KANSAS GEOLOGICAL SOCIETY
KANSAS WELL LOG BUREAU - KANSAS WELL SAMPLE BUREAU
KANSAS GEOLOGICAL SOCIETY BUILDING
508 EAST MURDOCK - WICHITA, KANSAS

COMPANY Texas Oil & Gas Corp.


SEC. 12 T. 27S R. 17W
LOC. 1980' FNL and
1320' FEL

FARM Clark "C" NO. 1

COUNTY Kiowa

TOTAL DEPTH 4,710'
COMM. May 13, 1977
SHOT OR TREATED
CONTRACTOR H-30, Inc.
ISSUED May 27, 1977

COMP. May 23, 1977

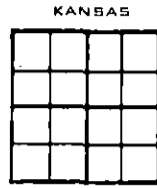

CASING

20	10	
15	8 5/8"	429' cemented w/ 450 sxs cement
12	6	
13	5	

PRODUCTION

ELEVATION 2119 KB

FIGURES INDICATE BOTTOM OF FORMATIONS

Sand	227'
Sand and Shale	350'
Shale	1,504'
Sand and Shale	2,090'
Lime and Shale	4,495'
Lime	4,614'
Lime and Shale	4,640'
Lime and Sand	4,710'
Rotary Total Depth	4,710'

I hereby certify the above and foregoing to be a true and correct log of the above described well as shown by the drilling reports.

H-30, Inc.

Dean Britting
Dean Britting

State of Kansas }
County of Sedgwick } ss:

Subscribed and Sworn to before me a Notary Public in and for said county and state this 27th day of May, 1977.

Elsie Willison
Elsie Willison-Notary Public

My Commission Expires:
June 30, 1978

RECEIVED
STATE CORPORATION COMMISSION

JUN 03 1977

CONSERVATION DIVISION
Wichita, Kansas

