


STATE OF KANSAS  
STATE CORPORATION COMMISSION

WELL PLUGGING RECORD

Give All Information Completely  
Make Required Affidavit  
Mail or Deliver Report to  
Conservation Division  
State Corporation Comm.  
245 North Water  
Wichita, KS 67202

Kiowa County, Sec. 12 Twp. 27 Rge. 17 E/W  
Location as "NE/CNW $\frac{1}{4}$ SW $\frac{1}{4}$ " or footage from lines  
C NW NE

Lease Owner Hummon Corporation  
Lease Name Clark Well No. 1  
Office Address 400 One Main Place, Wichita 67202  
Character of Well (Completed as Oil, Gas or Dry Hole)  
Dry Hole  
Date Well completed 9/16/79 19  
Application for plugging filed 9/16/79 19  
Application for plugging approved 9/16/79 19  
Plugging commenced 9/16/79 19  
Plugging completed 9/16/79 19  
Reason for abandonment of well or producing formation

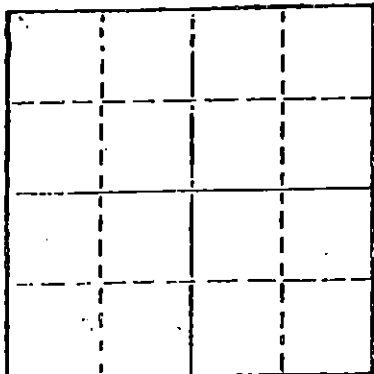

Locate well correctly on above  
Section Plot

If a producing well is abandoned, date of last production 19

Was permission obtained from the Conservation Division or its agents before plugging was commenced? Yes

Name of Conservation Agent who supervised plugging of this well Wm. T. Owen  
Producing formation Depth to top Bottom Total Depth of Well  
Show depth and thickness of all water, oil and gas formations. RTD 4690'

OIL, GAS OR WATER RECORDS

CASING RECORD

FORMATION	CONTENT	FROM	TO	SIZE	PUT IN	PULLED OUT
	Surface	0	391	8-5/8	yes	no

Describe in detail the manner in which the well was plugged, indicating where the mud fluid was placed and the method or methods used in introducing it into the hold. If cement or other plugs were used, state the character of same and depth placed, from feet to feet for each plug-set.

1st plug @ 600' with 40 sacks  
2nd plug at 390' with 40 sacks  
Solid bridge @ 40' with 12 sacks  
3 sacks in rathole  
Job complete @ 4p.m. 9/16/79

RECEIVED  
STATE CORPORATION COMMISSION

OCT - 2 1979

10-2-79

Wichita, Kansas

(If additional description is necessary, use BACK of this sheet)

Name of Plugging Contractor Slawson Drilling Company, Inc.


STATE OF Kansas COUNTY OF Sedgwick, ss.  
James C. Remsberg, of Slawson Drilling Co., Inc. (employee of owner) or (owner or operator) of the above-described well, being first duly sworn on oath, says: That I have knowledge of the facts, statements, and matters herein contained and the log of the above-described well as filed and that the same are true and correct. So help me God.

(Signature) James C. Remsberg  
James C. Remsberg  
200 Douglas Building, Wichita, Kansas 67202  
(Address)

SUBSCRIBED AND SWORN TO before me this 28 day of September, 1979

Mary Lou Taylor  
Mary Lou Taylor Notary Public.

My commission expires January 17, 1981

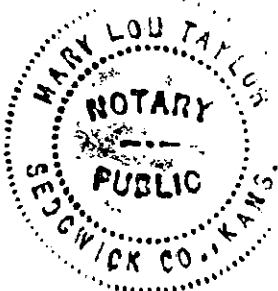

DRILLERS LOG

OPERATOR: Hummon Corporation  
 400 One Main Place  
 Wichita, Kansas 67202

LEASE: Clark #1  
 C NW NE Sec. 12-27S-17W  
 Kiowa County, Kansas

CONTRACTOR: SLAWSON DRILLING COMPANY, INC.  
 200 Douglas Building  
 Wichita, Kansas 67202

COMMENCED: 9/9/79

COMPLETED: 9/16/79

RTD: 4690'

SURFACE CASING: 8-5/8" set at 391' with 300 sx cement

0' to 396' 12 1/4" Surface Hole  
 396' to 1040' Sand & Shale  
 1040' to 3368' Shale  
 3368' to 3890' Lime & Shale  
 3890' to 4090' Shale & Lime  
 4090' to 4627' Lime & Shale  
 4627' to 4690' Shale & Lime  
 RTD 4690'

RECEIVED  
 STATE CORPORATION COMMISSION

OCT - 2 1979

CONSERVATION DIVISION  
 STATE CORPORATION COMMISSION

STATE OF KANSAS

COUNTY OF SEDGWICK

I, James C. Remsberg, of the Slawson Drilling Company, Inc.  
 hereby state the above is an accurate copy of the Clark #1 log for Hummon Corporation.

*James C. Remsberg*  
 James C. Remsberg

Subscribed and sworn to me this  
 28th day of September, 1979

*Mary Lou Taylor*  
 Mary Lou Taylor, Notary

My commission expires January 17, 1981

