


STATE OF KANSAS
STATE CORPORATION COMMISSION

WELL PLUGGING RECORD

Give All Information Completely
Make Required Affidavit
Mail or Deliver Report to
Conservation Division
State Corporation Comm.
245 North Water
Wichita, KS 67202

KIOWA County, Sec. 12 Twp. 27S Rge. 17W E/W
Location as "NE/CNW $\frac{1}{4}$ SW $\frac{1}{4}$ " or footage from lines
2310 FNL 1320' FWL

Lease Owner TEXAS OIL AND GAS CORPORATION
Lease Name Clark Well No. C - 2
Office Address 200 W Douglas, Suite 300, Wichita, Kansas
Character of Well (Completed as Oil, Gas or Dry Hole)

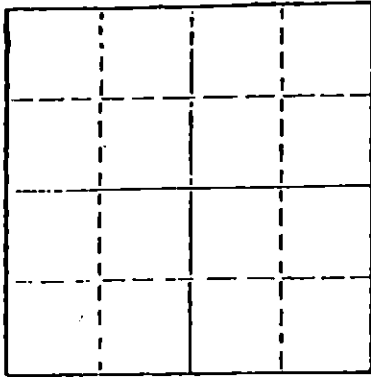

Locate well correctly on above
Section Plot

GAS
Date Well completed 3 - 21 - 78 1978
Application for plugging filed June 26 1978
Application for plugging approved June 28 1978
Plugging commenced 8-28 1978
Plugging completed 9-5 1978
Reason for abandonment of well or producing formation
Not Productive
If a producing well is abandoned, date of last production 19

Was permission obtained from the Conservation Division or
its agents before plugging was commenced? Yes

Name of Conservation Agent who supervised plugging of this well Bill Owens
Producing formation _____ Depth to top _____ Bottom _____ Total Depth of Well 4730
Show depth and thickness of all water, oil and gas formations.

OIL, GAS OR WATER RECORDS

CASING RECORD

FORMATION	CONTENT	FROM	TO	SIZE	PUT IN	PULLED OUT
				8 5/8	412	None
				4 1/2	4699	2921.42

Describe in detail the manner in which the well was plugged, indicating where the mud fluid
was placed and the method or methods used in introducing it into the hold. If cement or other
plugs were used, state the character of same and depth placed, from _____ feet to
_____ feet for each plug set.

PUMPED IN 50 SACKS CEMENT. STOPPED RWE RWE PLUG 4000'. Ripped pipe at 3000'.

Pumped in 5 sacks Hull. 25 sacks jell. 1 25 sacks 50-50 nox. 3% cc

(If additional description is necessary, use BACK of this sheet)

Name of Plugging Contractor CLARKE CORPORATION

STATE OF Kansas COUNTY OF Barber, ss.
Elmo Margenstern (employee of owner) or (owner or operator)
of the above-described well, being first duly sworn on oath, says: That I have knowledge of
the facts, statements, and matters herein contained and the log of the above-described well
as filed and that the same are true and correct. So help me God.

(Signature) Elmo Margenstern
Medicine Lodge, Kansas 67104
(Address)

SUBSCRIBED AND SWORN TO before me this 4th day of September, 1978.

Jessie Hamilton
Notary Public.

Commission expires April 4, 1978




RECEIVED
STATE CORPORATION COMMISSION

SEP 15 1978
9-15-78
CONSERVATION DIVISION
Wichita, Kansas


CLARK "C" #2
2310' FNL @ 1320' FWL
SEC 12-273-17W

KIOWA Co., KANSAS

2115' G.L. 2123' K.B.

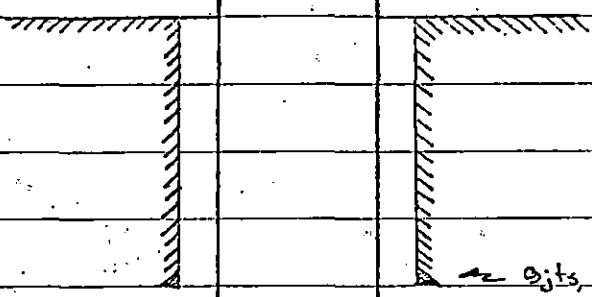

9 jts, 8 5/8", 24", K-55 SET @ 412' K.B.
cmt w/ 400 sxs

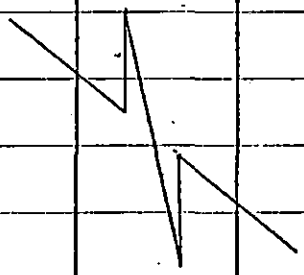

EST. CMT TOP @ 4100'

RECEIVED
STATE COMMISSION
JUL 27 1978
CONSERVATION DIVISION
Wichita, Kansas

perfs 4609-19

CMT RETAINER

BOTTOM OF TOP PKR 4644'

SLEEVE @ 4646'

TOP OF BOTTOM PKR 4648'

SQUEEZED

PBTD 4670'

115 jts, 4 1/2", 10.5", K-55 SET @ 4699' K.B.
cmt w/ 150 sxs

TD 4730'

WELL LOG

CLARK "C" #2
2310' FNL & 1320' FWL
Section 12-27S-17W
Kiowa County, Kansas

OPERATOR: TEXAS OIL & GAS CORP. COMMENCED: 3-12-78
CONTRACTOR: XPLOR DRILLING CO. COMPLETED: 3-21-78

CASING RECORD: Ran 9 jts. 8 5/8" 24# new surface casing, set @412'. Cement with 400 sacks. Ran 114 jts. 4 1/2" 10.5# new production casing, set @4710'. Cement with 150 sacks, 50/50 posmix.

<u>FORMATION</u>	<u>FROM</u>	<u>TO</u>	<u>ELEVATION</u>
Red Bed	0	1020	
Lime & Shale	1020	4730	
R.T.D.	4730		

RECEIVED
STATE COMMISSION
JUL 27 1978
CONSERVATION DIVISION
Wichita, Kansas

STATE OF KANSAS)
) SS:
COUNTY OF SEDGWICK)

I certify that this is a true and correct copy of the Driller's Log of the well drilled 2310' FNL & 1320' FWL of Section 12-27S-17W, Kiowa County, Kansas, to the best of my knowledge and belief.

XPLOR DRILLING CO.

Kirby C. Evers

Kirby C. Evers, Vice President

Subscribed and sworn to before me this 23rd. day of March, 1978.

MY COMMISSION EXPIRES:
August 25, 1978

Virginia Lee Smith

Virginia Lee Smith, Notary Public

