


STATE OF KANSAS
STATE CORPORATION COMMISSION
CONSERVATION DIVISION
P. O. BOX 17027
WICHITA, KANSAS 67217

FORM CP-4

WELL PLUGGING RECORD

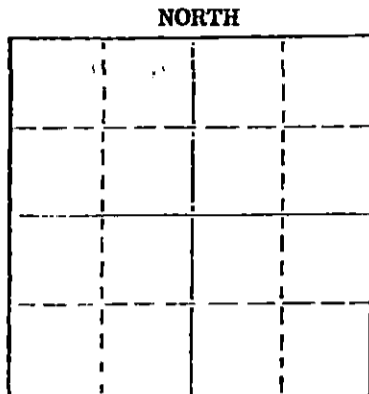

Locate well correctly on above Section Plat

Kiowa County, Sec. 18 Twp. 27 Rge. 17 (E) (W) X
Location as "NE/CNW/SE/SW" or footage from lines 100' W C NW/4
Lease Owner Imperial Oil Co.
Lease Name Thompson Well No. #1
Office Address Box 784 Great Bend, Kansas
Character of Well (completed as Oil, Gas or Dry Hole) Oil
Date well completed 19
Application for plugging filed 6-5-75 19
Application for plugging approved 19
Plugging commenced 6-16-75 19
Plugging completed 6-20-75 19
Reason for abandonment of well or producing formation
If a producing well is abandoned, date of last production 19
Was permission obtained from the Conservation Division or its agents before plugging was commenced?

Name of Conservation Agent who supervised plugging of this well G. R. Biberstein
Producing formation Depth to top Bottom Total Depth of Well 4840' Feet
Show depth and thickness of all water, oil and gas formations.

OIL, GAS OR WATER RECORDS

CASING RECORD

FORMATION	CONTENT	FROM	TO	SIZE	PUT IN	PULLED OUT
				4 1/2"	4830'	3043.75'
				8 5/8"	383'	

Describe in detail the manner in which the well was plugged, indicating where the mud fluid was placed and the method or methods used in introducing it into the hole. If cement or other plugs were used, state the character of same and depth placed, from feet to feet for each plug set.

Made bottom hole plug back with sand to 4700'. Mixed and ran 3 sacks cement thru dump bailer.
Bailed hole to 210' - set 10' rock bridge. Filled hole with 3 yards ready-mix concrete to base of cellar.

RECEIVED
STATE CORPORATION COMMISSION
JUN 20 1975

(If additional description is necessary, use BACK of this sheet)
Name of Plugging Contractor Southwest Casing Pulling Co. Conservation Division
Address Box 364 Great Bend, Kansas Wichita, Kansas

STATE OF Kansas COUNTY OF Barton
Southwest Casing Pulling Co. (employee of owner) or (owner or operator) of the above-described well, being first duly sworn on oath, says: That I have knowledge of the facts, statements, and matters herein contained and the log of the above-described well as filed and that the same are true and correct. So help me God.

(Signature) W. C. Spencer Sec.
Box 364 Great Bend, Kansas (Address)

Subscribed and Sworn to before me this 23 day of June 1975

My commission expires 24 October 1976
PUBLIC
BARTON COUNTY, KANSAS

Sidney D. Miller Notary Public

RECEIVED
STATE CORPORATION COMMISSION
JUN 24 1975 6-24-75
CONSERVATION DIVISION
Wichita, Kansas