


STATE OF KANSAS
STATE CORPORATION COMMISSION

WELL PLUGGING RECORD

Give All Information Completely
Make Required Affidavit
Mail or Deliver Report to
Conservation Division
State Corporation Comm.
245 North Water
Wichita, KS 67202

Kiowa County. Sec. 24 Twp. 27 S Rge. 17 E/W
Location as "NE/CNW/SW" or footage from lines
330-FNL & 330 FEL

Lease Owner Texas Oil & Gas Corp.
Lease Name Taylor Well No. C-1
Office Address 200 W. Douglas, Suite 300 Wichita Kansas
Character of Well (Completed as Oil, Gas or Dry Hole) _____

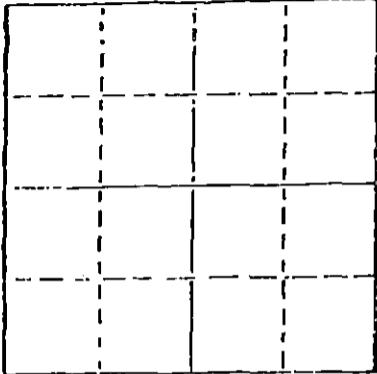

Locate well correctly on above
Section Plot

Gas Well
Date Well completed _____ 19____
Application for plugging filed 7-26 1978
Application for plugging approved March 31 1978
Plugging commenced July 25 1978
Plugging completed July 27 1978
Reason for abandonment of well or producing formation _____

non-producing
If a producing well is abandoned, date of last production _____ 19____

Was permission obtained from the Conservation Division or its agents before plugging was commenced? Yes

Name of Conservation Agent who supervised plugging of this well Bill Owens
Producing formation _____ Depth to top _____ Bottom _____ Total Depth of Well 4714
Show depth and thickness of all water, oil and gas formations.

OIL, GAS OR WATER RECORDS

CASING RECORD

FORMATION	CONTENT	FROM	TO	SIZE	PUT IN	PULLED OUT
				8 5/8	412'	
				4 1/2	4713'	

Describe in detail the manner in which the well was plugged, indicating where the mud fluid was placed and the method or methods used in introducing it into the hold. If cement or other plugs were used, state the character of same and depth placed, from _____ feet to _____ feet for each plug set.

Pumped 15 sack of sand over formation & chased with water. Mixed & spotted 4 sacks of cement with dump bailer over top of sand & perforations. Shot off pipe at 3500' would not move, shot off pipe at 3000', pipe was free. Pulled 15 joints, loaded hole. Pulled & recovered 75 joints of 4 1/2 pipe. Halliburton spotted plug at bottom of surface pipe at 412' & cemented well to top of well.

(If additional description is necessary, use BACK of this sheet)

Name of Plugging Contractor Pratt Well Service Inc. Kenneth C. Gates

STATE OF Kansas COUNTY OF Pratt, ss.
Kenneth C. Gates (employee of owner) or (owner or operator)
of the above-described well, being first duly sworn on oath, says: That I have knowledge of the facts, statements, and matters herein contained and the log of the above-described well as filed and that the same are true and correct. So help me God.


(Signature) Kenneth C. Gates
723 So. Minnesota Pratt, Ks
(Address)

SUBSCRIBED AND SWORN TO before me this 3rd day of October, 1978

Gaye E. Horn
Notary Public.

My commission expires 6-18-80

RECEIVED
STATE CORPORATION COMMISSION

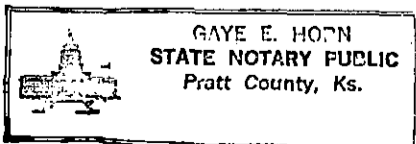

OCT 10 1978 10-10-78

CONSERVATION DIVISION
Wichita, Kansas

TAYLOR "C" #1

330' FNL § 330' FEL SEC. 24-275-17W

KIOWA Co., Ks

ELEV: 2110 G.L.

2118 K.B

8 7/8" 34# K-55 CSG SET @ 412' K.B.
CMT W/400 SX3

LMT TOP @ ± 4000'

per 4636-42

PBD @ ± 4680

4 1/2" 10.5# K-55 CSG SET @ 4713' K.B.
CMT W/145 SX3

RECEIVED
STATE CORPORATION COMMISSION
JUL 28 1978

CONSERVATION DIVISION
Wichita, Kansas

WELL LOG

TAYLOR "C" #1
330' FNL & 330' FEL
Section 24-27S-17W
Kiowa County, Kansas

OPERATOR: TEXAS OIL & GAS CORP.
CONTRACTOR: XPLOR DRILLING CO.

COMMENCED: 3-1-78
COMPLETED: 3-11-78

CASING RECORD: Ran 9 jts. 8 5/8" 24# new casing, set @412, cement with 400 sacks cement, 250 sacks Light Weight, 150 sacks Class H. By Allied. Ran 118 jts. production casing 4 1/2" new 10.5# set @4721', cement with 175 sacks cement, 50/50 Posmix. By Halliburton.

<u>FORMATION</u>	<u>FROM</u>	<u>TO</u>	<u>ELEVATION</u>
Sand	0	430	2110 Gr.
Red Bed	430	2177	2115 D.R.
Lime & Shale	2177	4725	2118 K.B.
R.T.D.	4725		

RECEIVED
STATE CORPORATION COMMISSION
JUL 28 1978
CONSERVATION DIVISION
Wichita, Kansas

STATE OF KANSAS)
) SS:
COUNTY OF SEDGWICK)

I certify that this is a true and correct copy of the Driller's Log of the well drilled 330' FNL & 330' FEL of Section 24-27S-17W, Kiowa County, Kansas, to the best of my knowledge and belief.

XPLOR DRILLING COMPANY

Kirby C. Evers
Kirby C. Evers, Vice President

Subscribed and sworn to before me this 14th. day of March, 1978.

MY COMMISSION EXPIRES:
August 25, 1980

Virginia Lee Smith
Virginia Lee Smith, Notary Public

