


STATE OF KANSAS
STATE CORPORATION COMMISSION

Give All Information Completely
Make Required Affidavit
Mail or Deliver Report to
Conservation Division
State Corporation Commission
245 North Water
Wichita, KS 67202

FORM CP-4

WELL PLUGGING RECORD

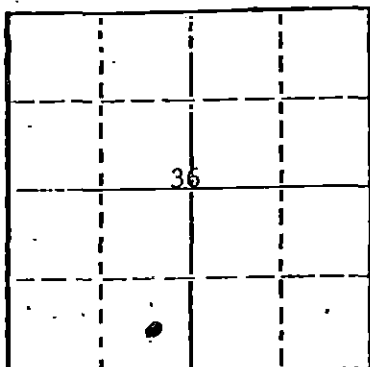

Locate well correctly on above
Section Plot

Kiowa County, Sec. 36 Twp. 27S Rge. 18 (E) (W)
Location as "NE/CNWSW" or footage from lines SE/SW
Lease Owner Anadarko Production Company
Lease Name MILLER "L" Well No. 1
Office Address P. O. Box 351, Liberal, Kansas
Character of Well (completed as Oil, Gas or Dry Hole) Dry Hole
Date well completed 1-8-76 19
Application for plugging filed 1-19-76 19
Application for plugging approved See Attached 19
Plugging commenced 1-8-76 19
Plugging completed 1-8-76 19
Reason for abandonment of well or producing formation Dry

If a producing well is abandoned, date of last production 19
Was permission obtained from the Conservation Division or its agents before plugging was commenced? Yes

Name of Conservation Agent who supervised plugging of this well G. Russell Biberstein
Producing formation Depth to top Bottom Total Depth of Well 4867 Feet
Show depth and thickness of all water, oil and gas formations.

OIL, GAS OR WATER RECORDS

CASING RECORD

FORMATION	CONTENT	FROM	TO	SIZE	PUT IN	PULLED OUT

Describe in detail the manner in which the well was plugged, indicating where the mud fluid was placed and the method or methods used in introducing it into the hole. If cement or other plugs were used, state the character of same and depth placed, from feet to feet for each plug set.
4867 TD, MI csg pullers, mixed 20 sxs cmt, pmpd plug to 4000. Shot off 4-1/2" csg 2820, spotted 50 sxs cmt 400-300', spotted 10 sxs cmt 30-0', comp 2:00 p.m. 1-8-76. P&A.

This well was previously TA on 9/19/75.

RECEIVED
STATE CORPORATION COMMISSION

Name of Plugging Contractor Sargent's Casing Pulling Service 4-27-76
Address 620 S. Lincoln, Liberal, Kansas 67901

STATE OF KANSAS COUNTY OF SEWARD
Conservation Division
Wichita, Kansas

(employee of owner) or (owner or operator) of the above-described well, being first duly sworn on oath, says: That I have knowledge of the facts, statements, and matters herein contained and the log of the above-described well and that the same are true and correct. So help me God.

NOTARY PUBLIC
Seward County, Kansas
My Commission Expires
September 9, 1976

(Signature) Stanley R. Shoemaker, Div. Ofc. Sup.
(Address) 23rd day of April 1976

My commission expires
NORMA JEAN TUCKER
NOTARY PUBLIC
Seward County, Kansas
My Commission Expires
September 9, 1976

Notary Public.

KANSAS DRILLERS LOG

S. 36 T. 27 R. 18 ^E _W

API No. 15 — 097 — 20,310
 County Number

Loc. SE SW

County Kiowa

Operator
Anadarko Production Co.

Address
Box 351 Liberal, Kansas


Well No. # 1 Lease Name Miller "L"

Footage Location
660 feet from (S) line 1980 feet from (E) (W) line

Principal Contractor Gabbert-Jones, Inc. Geologist

Spud Date 8-26-75 Total Depth 4867' P.B.T.D. 4700'

Date Completed 9-8-75 Will be plugged on approval Oil Purchaser

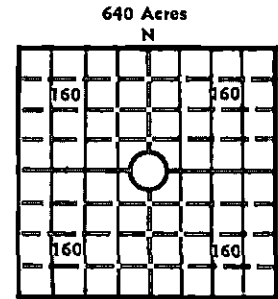

Elev.: Gr. 2182'

DF _____ KB _____

CASING RECORD

Report of all strings set— surface, intermediate, production, etc.

Purpose of string	Size hole drilled	Size casing set (in O.D.)	Weight lbs/ft.	Setting depth	Type cement	Sacks	Type and percent additives
Surface	12-1/4"	8-5/8"	20#	412'	Common	500	3% CC
Production	7-7/8"	4-1/2"	10.5#	4864'	Pozmix	200	.5% CFR-2

LINER RECORD

PERFORATION RECORD

Top, ft.	Bottom, ft.	Sacks cement	Shots per ft.	Size & type	Depth interval
			4 SPF		4750-56'
			Set CIBP		4700'
			4 SPF		4160-67'

TUBING RECORD

ACID, FRACTURE, SHOT, CEMENT SQUEEZE RECORD

Amount and kind of material used	Depth interval treated
Acidized w/250 gallons 10% MCA.	4750-56'
Acidized w/500 gallons 15% + 1500 gallons 28%.	4160-67'

INITIAL PRODUCTION

Date of first production		Producing method (flowing, pumping, gas lift, etc.)			
RATE OF PRODUCTION PER 24 HOURS	Oil	Gas	Water	Gas-oil ratio	
	bbls.	MCF	bbls.	CFPB	
Disposition of gas (vented, used on lease or sold)			Producing interval (s)		

INSTRUCTIONS: As provided in KCC Rule 82-2-125, within 90 days after completion of a well, one completed copy of this Drillers Log shall be transmitted to the State Geological Survey of Kansas, 4150 Monroe Street, Wichita, Kansas 67209. Copies of this form are available from the Conservation Division, State Corporation Commission, 3830 So. Meridian (P.O. Box 17027), Wichita, Kansas 66217. Phone AC 316-522-2206. If confidential custody is desired, please note Rule 82-2-125. Drillers Logs will be on open file in the Oil and Gas Division, State Geological Survey of Kansas, Lawrence, Kansas 66044.

Operator Anadarko Production Company DESIGNATE TYPE OF COMP.: OIL, GAS, DRY HOLE, SWDW, ETC.:

Well No. 1 Lease Name Miller "L" Dry Hole

S 36 T 27 S R 18 E W

WELL LOG

Show all important zones of porosity and contents thereof; cored intervals, and all drill-stem tests, including depth interval tested, cushion used, time tool open, flowing and shut-in pressures, and recoveries.

SHOW GEOLOGICAL MARKERS, LOGS RUN, OR OTHER DESCRIPTIVE INFORMATION.

FORMATION DESCRIPTION, CONTENTS, ETC.	TOP	BOTTOM	NAME	DEPTH
Sand-Clay	0	195		
Shale-Sand	195	414		
Redbed-Shale	414	1005		
Shale-Shells-Salt	1005	1700		
Shale-Shells	1700	2105		
Shale-Lime	2105	2400		
Lime-Shale	2400	3445		
Lime	3445	3605		
Lime-Shale	3605	4070		
Lime	4070	4867		
Total Depth		4867		

DST #1 4163-72' (Lansing), 15 min PF w/strong blo, no gas to surface, TO 40 min w/GTS 13 min, 20 min ga 9.5 MCFD, 25 min ga 11.6 MCFD, 30 min ga 13.5 MCFD, 35 min ga 15.5 MCFD, 40 min ga 17.3 MCFD, REC 85' fluid, 61' sli GC drlg mud, 24' wtry GC drlg mud. ISIP 1336# (30), PFP 27-54#, FFP 36-72#, FSIP 1445# (80), HP 2139-2010#.

DST #2 4190-4211' (Lansing), 28 min PF w/weak blo, TO 40 min w/wk to good blo, REC 171 fluid, 96' drlg mud, 75' hvy G&sli oil cut drlg mud. ISIP 964# (30), PFP 82-82#, FFP 90-90#, FSIP 1164# (60), HP 2175-2159#.

USE ADDITIONAL SHEETS, IF NECESSARY TO COMPLETE WELL RECORD.

Date Received	<p style="text-align: center;"><i>Stanley Shoemaker</i> Stanley Shoemaker <small>Signature</small> Division Office Supervisor <small>Title</small> December 18, 1975 <small>Date</small></p>
---------------	---