

Give All Information Completely
Make Required Affidavit
Mail or Deliver Report to:
Conservation Division
State Corporation Commission
800 Bittling Building
Wichita, Kansas

WELL PLUGGING RECORD

NORTH

Locate well correctly on above
Section Plat

Reno County, Sec. 20 Twp. 25 Rge. 10 (E) (W)
Location as "NE/CNW&SW" or footage from lines NW NW of NW 990' North Line
Lease Owner Schermerhorn Oil Corporation
Lease Name Nies Well No. 1
Office Address 714 First National Bldg., Tulsa, Oklahoma
Character of Well (completed as Oil, Gas or Dry Hole) Dry Hole
Date well completed 5-24-19 54
Application for plugging filed 5-24-19 54
Application for plugging approved 5-24-19 54
Plugging commenced 5-24-19 54
Plugging completed 6-4-19 54
Reason for abandonment of well or producing formation Dry Hole

If a producing well is abandoned, date of last production 19
Was permission obtained from the Conservation Division or its agents before plugging was commenced? Yes

Name of Conservation Agent who supervised plugging of this well Dirkey
Producing formation Depth to top Bottom Total Depth of Well 3990 Feet
Show depth and thickness of all water, oil and gas formations.


OIL, GAS OR WATER RECORDS

CASING RECORD

FORMATION	CONTENT	FROM	TO	SIZE	PUT IN	PULLED OUT
		0	240	8 5/8	Cemented	

Describe in detail the manner in which the well was plugged, indicating where the mud fluid was placed and the method or methods used in introducing it into the hole. If cement or other plugs were used, state the character of same and depth placed, from feet to feet for each plug set.

3990 to 240 Mud
240 to Bottom Cellar Cement

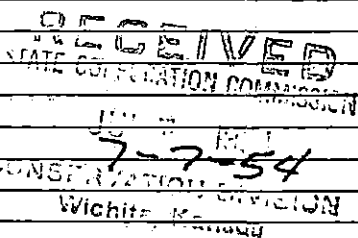

(If additional description is necessary, use BACK of this sheet)
Name of Plugging Contractor Badger Drillers, Inc.
Address Great Bend, Kansas

STATE OF Oklahoma, COUNTY OF Tulsa, ss.
Don E. Bunkert Henry J. Sherman (employee of owner) or (owner or operator) of the above-described well, being first duly sworn on oath, says: That I have knowledge of the facts, statements, and matters herein contained and the log of the above-described well as filed and that the same are true and correct. So help me God.


(Signature) Henry J. Sherman
714 First National Bldg., Tulsa, Oklahoma (Address)

SUBSCRIBED AND SWORN to before me this 6th day of June, 19 54

My commission expires 10-20-57

Opal Gabriel
Notary Public.

24-7368-8 3-53-20M

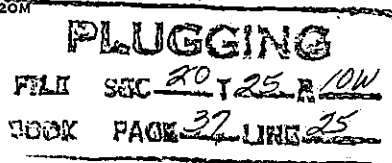

DAVID NIES #1
SE NW Sec. 20-25S-10W
Reno County, Kansas
Schermerhorn Oil Corporation

Drilling Started 5-7-54
Drilling Completed 5-24-54
8 5/8" 24# Casing Cemented @ 236'

<u>From</u>	<u>To</u>	<u>Formation</u>	<u>Remarks</u>
0	40	Sand	
40	175	Clay Sand	
175	236	Red Bed	8 5/8" 24# Casing Set w/ 275 sacks
236	500	Red Bed	
500	528	Anhydrite	
528	1200	Shale & Shells	
1200	1650	Lime & Shale	
1650	1956	Lime	
1956	2960	Lime & Shale	
2960	3021	Lime	
3021	3127	Lime & Shale	
3127	3301	Lime	
3301	3387	Lime & Sand	
3387	3515	Lime & Shale	
3515	3980	Lime	
3980	4004	Chert-Lime	
4004	4016	Lime	
4016	4160	Lime & Shale	
4160	4168	Lime Chert	
4168	4275	Lime	
4275	4290	Sand & Shale	
4290	4390	Lime	Total Depth


This is a certified true copy of the Driller's Log as shown on the daily drilling reports.

Ray F. Fisher
BADGER DRILLERS, INC.

Subscribed and sworn to before me this 8th day of June, 1954

Opal Graham
Notary Public

RECEIVED
COMMISSION EXPIRES IN

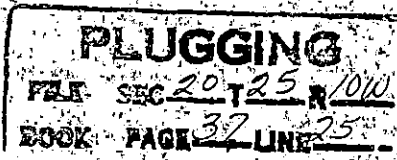

6-9-54
FICION