


STATE OF KANSAS  
STATE CORPORATION COMMISSION

Form CP-4

WELL PLUGGING RECORD

Give All Information Completely  
Make Required Affidavit  
Mail or Deliver Report to:  
Conservation Division  
State Corporation Commission  
P. O. Box 17027  
Wichita, Kansas 67217  
NORTH

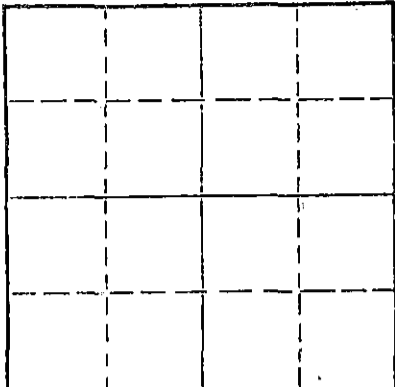

Locate well correctly on above  
Section Plat

Ford County, Sec. 35 Twp. 27S Rge. 24W (E) (W)  
Location as "NE/CNW/SW" or footage from lines NE NE NW  
Lease Owner Davies & Fitzgerald/ Marsh Oil & Associates  
Lease Name Barngrover Well No. 1  
Office Address 1303 Philtower Bldg., Tulsa, Oklahoma  
Character of Well (completed as Oil, Gas or Dry Hole) D & A  
Date well completed September 7 1973  
Application for plugging filed September 7 1973  
Application for plugging approved September 7 1973  
Plugging commenced September 7 1973  
Plugging completed September 7 1973  
Reason for abandonment of well or producing formation D & A

If a producing well is abandoned, date of last production 19  
Was permission obtained from the Conservation Division or its agents before plugging was commenced? Yes

Name of Conservation Agent who supervised plugging of this well Edgar Eves  
Producing formation \_\_\_\_\_ Depth to top \_\_\_\_\_ Bottom \_\_\_\_\_ Total Depth of Well 5091 Feet  
Show depth and thickness of all water, oil and gas formations.

OIL, GAS OR WATER RECORDS

CASING RECORD

FORMATION	CONTENT	FROM	TO	SIZE	PUT IN	PULLED OUT
				8 5/8"	413	-0-

Describe in detail the manner in which the well was plugged, indicating where the mud fluid was placed and the method or methods used in introducing it into the hole. If cement or other plugs were used, state the character of same and depth placed, from \_\_\_\_\_ feet to \_\_\_\_\_ feet for each plug set.

Plug w/70 sx @ 2750',  
35 sx @ 410' & 10 sx @ 40'

RECEIVED  
STATE CORPORATION COMMISSION

SEP 11 1973

CONSERVATION DIVISION  
Wichita, Kansas

(If additional description is necessary, use BACK of this sheet)

Name of Plugging Contractor B & B Drilling, Inc.  
Address 720 Union Center, Wichita, Ks.

STATE OF Kansas, COUNTY OF Sedgwick, ss.  
Bill Lahar (employee of owner) or (owner or operator) of the above-described well, being first duly sworn on oath, says: That I have knowledge of the facts, statements, and matters herein contained and the log of the above-described well as filed and that the same are true and correct. So help me God.

(Signature) Bill Lahar  
B & B DRILLING, INC.  
720 Union Center, Wichita, Ks.  
(Address)

SUBSCRIBED AND SWORN to before me this 10th day of September, 1973

My commission expires January 29, 1977

Betty M. Maloney  
Notary Public.

RECEIVED  
STATE CORPORATION COMMISSION

September 10, 1973

DRILLERS LOG

SEP 11 1973

CONSERVATION DIVISION  
Wichita, Kansas

Re: #1 Barngrover  
NE NE NW  
Sec. 35-27S-24W  
Ford County, Kansas


OPERATOR: Marsh Oil & Associates  
CONTRACTOR: B & B Drilling, Inc.  
COMMENCED: August 25, 1973  
COMPLETED: September 7, 1973

8 5/8" @ 413' w/225 sx

0	80	Shale	
80	200	Sand	
200	415	Shale & Shells	
415	965	Shale & Sand	
965	1500	Shale	
1500	1515	Bl. Anhydrite	
1515	2365	Shale	
2365	2458	Shale & Lime	
2458	2574	Anhydrite & Lime	
2574	2658	Lime & Shale	
2658	2710	Lime	DST #1
2710	2892	Lime & Shale	
2892	3300	Lime	DST #2
3300	4295	Lime & Shale	
4295	4540	Lime	
4540	4642	Lime & Shale & Chert	
4642	5091	Lime	DST #3 & DST #4
5091		RTD	D & A

We certify the above and foregoing to be true and correct copy of the log on the #1 Barngrover, located in Ford County, Kansas.

B & B DRILLING, INC.

  
Bill Lahar, President

Subscribed and sworn to before me this 10th day of September, 1973.

  
Betty M. Maloney Notary Public

My Commission Expires: 1-29-77