

STATE OF KANSAS
STATE CORPORATION COMMISSION


Form CP-4

Give All Information Completely
Make Required Affidavit
Mail or Deliver Report to:
Conservation Division
State Corporation Commission
P. O. Box 17027
Wichita, Kansas 67217
NORTH

WELL PLUGGING RECORD

Ford County, Sec. 12 Twp. 27S Rge. 26 ~~XXX~~ (W)
C SW SE

Location as "NE/CNW/SW" or footage from lines _____
Lease Owner Beren Corporation
Lease Name Sutton #1 Well No. 1
Office Address 970 Fourth Financial Center, Wichita, Kansas 67202
Character of Well (completed as Oil, Gas or Dry Hole) Dry Hole
Date well completed April 27 19 75
Application for plugging filed _____ 19 _____
Application for plugging approved April 29 19 75
Plugging commenced April 27 19 75
Plugging completed April 27 19 75
Reason for abandonment of well or producing formation Dry Hole

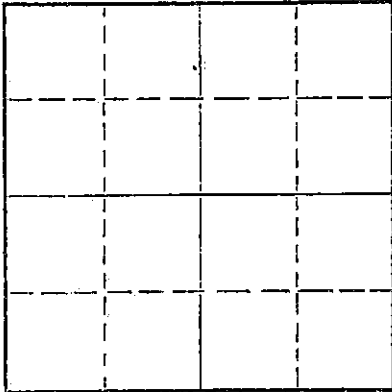

Locate well correctly on above
Section Plat

If a producing well is abandoned, date of last production _____ 19 _____
Was permission obtained from the Conservation Division or its agents before plugging was commenced? Yes

Name of Conservation Agent who supervised plugging of this well Clarence Thomas
Producing formation _____ Depth to top _____ Bottom _____ Total Depth of Well 2808 Feet
Show depth and thickness of all water, oil and gas formations.

OIL, GAS OR WATER RECORDS

CASING RECORD

FORMATION	CONTENT	FROM	TO	SIZE	PUT IN	PULLED OUT
				8-5/8	250'	None

Describe in detail the manner in which the well was plugged, indicating where the mud fluid was placed and the method or methods used in introducing it into the hole. If cement or other plugs were used, state the character of same and depth placed, from _____ feet to _____ feet for each plug set.

Spotted 50sx @ 850'
35sx @ 550'
10sx @ 0 - 40'
2sx in rat hole

RECEIVED
STATE CORPORATION COMMISSION

JUL 17 1975

CONSERVATION DIVISION
Wichita, Kansas

(If additional description is necessary, use BACK of this sheet)
Name of Plugging Contractor Francis Melland Drilling Company
Address Box 746, McPherson, Kansas 67460

STATE OF KANSAS, COUNTY OF SEDGWICK, ss.
Jim Thatcher (employee of owner) ~~or (owner or operator)~~ of the above-described well, being first duly sworn on oath, says: That I have knowledge of the facts, statements, and matters herein contained and the log of the above-described well as filed and that the same are true and correct. So help me God.

(Signature) Jim Thatcher
970 Fourth Financial Center, Wichita, Ks. 67202
(Address)



this 16th day of July, 19 75
Catherine A. Carr
Catherine A. Carr Notary Public.

My commission expires January 13, 1977

Mp Petroleum Company Inc.

POST OFFICE BOX 746 • McPHERSON, KANSAS 67460
PHONE 316 241-3340

DRILLERS LOG

OPERATOR: Beren Corporation 970 Fourth Financial Center Wichita, Kansas 67202	CONTRACTOR: M-P Petroleum, Inc. P. O. Box 746 McPherson, Kansas 67460
LEASE: Sutton WELL: No. 1	LOCATION: C SW SE Sec. 12-27S-26W Ford County, Kansas
Total Depth: 2808 K.B.	
Casing 8 5/8" @ 250 s 160 sks common cement, 160 sks 60-40 poz mix, 6% gel, 3% cal-cl, followed with 50 sks 60-40 poz mix, 2% gel, 3% cal-cl.	Commenced: 4-16-75 Completed: 4-27-75 Elevation: Tight Hole Status: Plugged

DEPTH AND FORMATION All measured from R.B.

Sand & Shale	200	Anhydrite	1705
Shale	890	Shale & Lime	1734
Shale & Lime	1070	Shale & Lime Streaks	2025
Shale & Lime Streaks	1520	Shale & Lime	2808
Shale & Lime	1675		

RECEIVED
STATE CORPORATION COMMISSION

JUL 17 1975

State of Kansas
ss
County of McPherson

CONSERVATION DIVISION
Wichita, Kansas

I, James R. Patterson, of M-P Petroleum, Inc., state that the above and foregoing is a true and correct log of the above captioned well.

James R. Patterson
James R. Patterson

Subscribed and sworn to before me this 8th day of May 1975.

My commission expires: July 1, 1978

Patricia Jo Winter
Notary Public

