

STATE OF KANSAS
STATE CORPORATION COMMISSION

WELL PLUGGING RECORD

Give All Information Completely
Make Required Affidavit
Mail or Deliver Report to
Conservation Division
State Corporation Comm.
245 North Water
Wichita, KS 67202

Kiowa County, Sec. 32 Twp. 27S Rge. 17W E/W
Location as "NE/CNW $\frac{1}{4}$ SW $\frac{1}{4}$ " or footage from lines
300' W & 200' S of SW SE NW

Lease Owner Lee Banks
Lease Name Roenbaugh Well No. 1

Office Address 200 W. Douglas, Suite 550, Wichita, KS 67202
Character of Well (Completed as Oil, Gas or Dry Hole)

Dry Hole


Date Well completed November 12, 1980
Application for plugging filed November 12, 1980
Application for plugging approved November 12, 1980
Plugging commenced November 12, 1980
Plugging completed November 12, 1980
Reason for abandonment of well or producing formation

Dry Hole

If a producing well is abandoned, date of last production 19

Was permission obtained from the Conservation Division or its agents before plugging was commenced? Yes

Name of Conservation Agent who supervised plugging of this well Wm. T. Owen
Producing formation Depth to top Bottom Total Depth of Well 4810'
Show depth and thickness of all water, oil and gas formations.

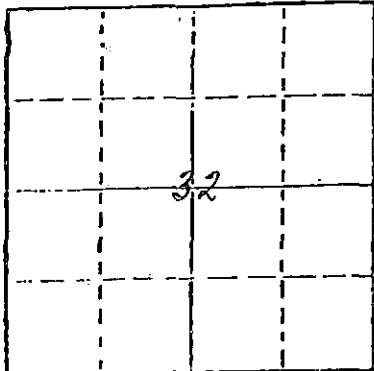

Locate well correctly on above Section Plat

OIL, GAS OR WATER RECORDS

CASING RECORD

FORMATION	CONTENT	FROM	TO	SIZE	PUT IN	PULLED OUT
		0'	445'	8-5/8"	438.96'	None

Describe in detail the manner in which the well was plugged, indicating where the mud fluid was placed and the method or methods used in introducing it into the hold. If cement or other plugs were used, state the character of same and depth placed, from feet to feet for each plug set.

Plugged with 60 sacks cement at 480';
10 sacks cement at 40'; and 10 sacks
cement in rat hole.


(If additional description is necessary, use BACK of this sheet)

Name of Plugging Contractor Allied Cementing Co.

STATE OF KANSAS COUNTY OF SEDGWICK CONSERVATION DIVISION
John D. Knightley Agent (employee of owner) forsa (owner or operator)
of the above-described well, being first duly sworn on oath, says: That I have knowledge of the facts, statements, and matters herein contained and the log of the above-described well as filed and that the same are true and correct. So help me God.

(Signature) [Signature]
221 S. Broadway, Suite 400, Wichita, KS 67202
(Address)

SUBSCRIBED AND SWORN TO before me this 18th day of November, 19 80

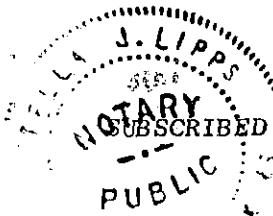

[Signature]
Notary Public.

My commission expires March 12, 1983

Lee Banks
200 W. Douglas, Suite 550
Wichita, Kansas 67202

- Roenbaugh #1
300' W & 200' S of SW SE NW
Section 32-27S-17W
Kiowa County, Kansas

Contractor: D. R. Lauck Oil Company, Inc.
221 S. Broadway, Suite 400
Wichita, Kansas 67202

Commenced: October 31, 1980
Completed: November 12, 1980

Drillers Log

Sand, Clay & Shale	450
Red Bed & Shale	1135
Shale & Lime	2191
Shale	2710
Lime & Shale	2885
Shale & Lime	3326
Lime & Shale	3547
Shale & Lime	3720
Shale	3940
Lime	4060
Lime & Shale	4380
Lime	4699
Lime & Shale	4714
Lime	4773
Lime & Shale	4810 RTD

RECEIVED
OIL & GAS COMMISSION

NOV 19 1980

CONSERVATION DIVISION
Wichita, Kansas