


STATE OF KANSAS
STATE CORPORATION COMMISSION
Give All Information Completely
Make Required Affidavit
Mail or Deliver Report to:
Conservation Division
State Corporation Commission
211 No. Broadway
Wichita, Kansas

WELL PLUGGING RECORD

Kiowa County, Sec. 24 Twp. 27S Rge. (E) 18 (W)

Location as "NE/CNW/SW" or footage from lines C S/2 SE/4
Lease Owner Pan-Western Petroleum, Inc.
Lease Name Woods Well No. 1
Office Address 521 Petroleum Building, Wichita, Kansas
Character of Well (completed as Oil, Gas or Dry Hole) Dry Hole
Date well completed December 5 19 63
Application for plugging filed December 5 19 63
Application for plugging approved December 5 19 63
Plugging commenced December 5 19 63
Plugging completed December 5 19 63
Reason for abandonment of well or producing formation Dry Hole

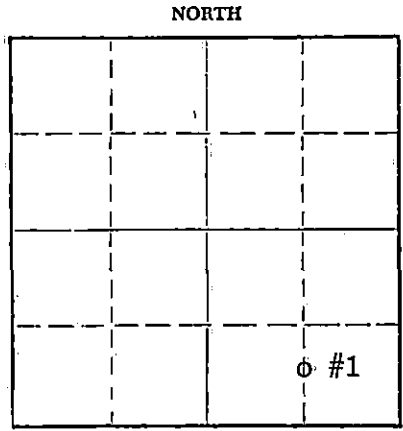

Locate well correctly on above Section Plat

If a producing well is abandoned, date of last production -- 19
Was permission obtained from the Conservation Division or its agents before plugging was commenced? Yes

Name of Conservation Agent who supervised plugging of this well Archie Elving, Pratt, Kansas
Producing formation -- Depth to top -- Bottom -- Total Depth of Well 5136 Feet
Show depth and thickness of all water, oil and gas formations.

OIL, GAS OR WATER RECORDS

CASING RECORD

FORMATION	CONTENT	FROM	TO	SIZE	PUT IN	PULLED OUT
		-0-	303	8-5/8"	303	-0-

Describe in detail the manner in which the well was plugged, indicating where the mud fluid was placed and the method or methods used in introducing it into the hole. If cement or other plugs were used, state the character of same and depth placed, from feet to feet for each plug set.

Filled hole to 275' with rotary mud. Pushed wooden plug and 1/4 sack hulls to fluid with drill pipe. Cemented with 25 sacks cement through drill pipe. Filled hole to 40' with mud. Pushed wooden plug and 1/4 sack hulls to fluid. Cemented with 10 sacks cement. Put 2 sacks cement in rat hole. Job completed at 6:00 P. M. 12/5/63.

RECEIVED
STATE CORPORATION COMMISSION

DEC 18 1963


CONSERVATION DIVISION
Wichita, Kansas

(If additional description is necessary, use BACK of this sheet)

Name of Plugging Contractor Western Petroleum Co., Inc.
Address P. O. Box 524, Great Bend, Kansas

STATE OF KANSAS COUNTY OF BARTON, ss.
F. L. Copeland (employee of owner) or (owner or operator) of the above-described well, being first duly sworn on oath, says: That I have knowledge of the facts, statements, and matters herein contained and the log of the above-described well as filed and that the same are true and correct. So help me God.

(Signature) F. L. Copeland
F. L. Copeland, 925 Patton Road, Great Bend, Ks.
(Address)

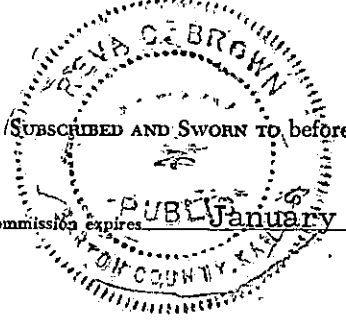

Subscribed and sworn to before me this 16th day of December, 19 63
Reva C. Brown Notary Public



DRILLER'S LOG
Woods #1

COMPANY: LEBEN DRILLING, INC.

ELEVATION: 2153 DF
2155 KB

CONTRACTOR: WESTERN PETROLEUM CO., INC.

CASING RECORD: 7 JTS. 8-5/8"
20# CASING

COMMENCED: NOVEMBER 12, 1963

COMPLETED: DECEMBER 5, 1963

TOTAL DEPTH: 5136'

DESCRIPTION: C S/2 SE/4
SECTION 24-T27S-R18W
KIOWA COUNTY, KANSAS

RECEIVED
STATE CORPORATION COMMISSION

DEC 12 1963

CONSERVATION DIVISION
Wichita, Kansas

FORMATION	FROM	TO	REMARKS
SAND	0	145	SPURRED @ 5:30 PM, 11/16/63. RAN 7 JTS. 8-5/8" 28# USED PIPE, TALLY OVERALL 306.42'. SET @ 303'. CEMENTED WITH 275 SXS. COMMON CEMENT, 2% GEL, 3% CC. PLUG DOWN @ 10:00 PM. CEMENT CIRCULATED. DST #1 - 4696-4720. OPEN 5 MINS. SHUT IN 30 MINS. OPEN 2 HRS. FINAL SHUT IN 45 MINS. GAS TO SURFACE IN 4 MINS. IN 15 MINS. GAUGED 1,002 MCFG, DIMINISHED TO 434 MCFG IN 2 HRS. RECOVERED 75' OF ROTARY MUD. IBHP 1290#; FP 0#; FBHP 1060#; HH 2420#. DST #2 - 4720-4760. 5 MIN. PRELIMINARY BLOW. OPEN 2 HRS. GAS TO SURFACE IN 13 MINS. TOO WEAK TO GAUGE. RECOVERED 130' OF ROTARY MUD. IBHP 1500#/30 MIN; FBHP 1460#/45 MIN; FP 0#; HH 2450#. DST #3 - 4767-4820. PRELIMINARY OPENING 5 MINS. OPEN 2 1/2 HRS. BY PASSED TOOL IN 8 MINS. BLOW INTERMITTENT FOR REMAINDER OF TEST. RECOVERED 60' SLIGHTLY WATERY MUD. IBHP 1316#/45 MINS; FP 100#; FBHP 1120#/15 MINS; HH 2690#. DST #4 - 4691-4727. OPEN 3 HRS. GTS 4". 15" GAUGE 627 MCF. END OF 3 HRS. GAUGED 560 MCF. RECOVERED 420' GCM, 30' GCWM. IBHP 1574#/45 MIN; FBHP 1467/45 MIN; IFP AND FFP 167#. WELEX RAN GAMMA RAY-ACOUSTIC GUARD. P & A - 12/5/63.
SHALE	145	303	
SHALE & RED BED	303	380	
RED BED	380	482	
ANHYDRITE	482	493	
RED BED	493	1235	
SHALE & SHELLS	1235	2160	
LIME AND SHALE	2160	2362	
LIME	2362	2742	
LIME & SHALE	2742	3243	
LIME & SHALE SAND	3243	3333	
LIME & SHALE	3333	3595	
LIME	3595	3818	
LIME & SHALE	3818	3905	
LIME, CHALK & SHALE	3905	3997	
LIME & SHALE	3997	4150	
LIME	4150	4720	
CHERT LIME	4720	4760	
SHALE-LIME	4760	4798	
LIME, SAND SHALE	4798	4820	
SHALE-SAND CHERT	4820	4847	
LIME & CHERT	4847	4924	
CHERT-LIME	4924	4978	
LIME & CHERT	4978	5025	
LIME & SHALE	5025	5136	
RTD	5136		
<u>ELECTRIC LOG TOPS</u>			
HEEBNER	3994	-1839	
BROWN LIME	4140	-1985	
LANSING	4155	-2000	
B/KC	4536	-2381	
CHEROKEE SHALE	4656	-2501	
MISSISSIPPIAN	4707	-2549	
KINDERHOOK SHALE	4772	-2617	
KINDERHOOK SAND	4788	-2633	
VIOLA	4855	-2700	
SIMPSON	5010	-2855	
ARBUCKLE	5106	-2951	

STATE OF KANSAS }
COUNTY OF BARTON } SS

I, THE UNDERSIGNED, BEING DULY SWORN ON OATH, STATE THAT THE ABOVE STATEMENT AND LOG ARE TRUE AND A CORRECT RECORD AND LOG OF THE WELL DRILLED AT THE LOCATION ABOVE DESCRIBED.

WESTERN PETROLEUM CO., INC.

F. L. Copeland
F. L. COPELAND, DRILLING SUPT.

SUBSCRIBED AND SWORN TO BEFORE ME THIS 10TH DAY OF DECEMBER, 1963.

Reva C. Brown
REVA C. BROWN, NOTARY PUBLIC

MY COMMISSION EXPIRES JANUARY 16, 1967.