


STATE OF KANSAS
STATE CORPORATION COMMISSION

Form CP-4

Give All Information Completely
Make Required Affidavit
Mail or Deliver Report to:
Conservation Division
State Corporation Commission

WELL PLUGGING RECORD

P. O. Box 17027
Wichita, Kansas 67217
NORTH

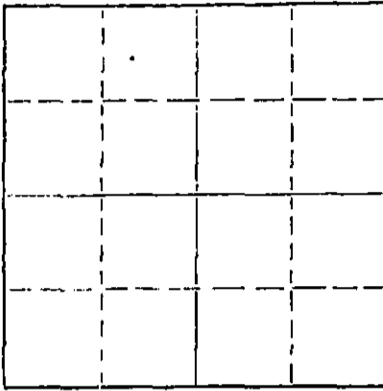

Locate well correctly on above
Section Plat

Kiowa County. Sec. 9 Twp. 27S Rge. 17W (E) (W)
Location as "NE/CNW/SW" or footage from lines: NE SW SW
Lease Owner: F. G. Holl
Lease Name: Sparke #1 Well No. _____
Office Address: 6127 East Kellogg, Wichita, Kansas 67207
Character of Well (completed as Oil, Gas or Dry Hole) Dry Hole
Date well completed July 18, 1974
Application for plugging filed July 18, 1974
Application for plugging approved July 18, 1974
Plugging commenced 4:30 PM, July 18, 1974
Plugging completed 5:30 PM, July 18, 1974
Reason for abandonment of well or producing formation Dry Hole

If a producing well is abandoned, date of last production _____ 19____
Was permission obtained from the Conservation Division or its agents before plugging was commenced? Yes

Name of Conservation Agent who supervised plugging of this well G. R. Biberstein
Producing formation _____ Depth to top _____ Bottom _____ Total Depth of Well 1810' Feet
Show depth and thickness of all water, oil and gas formations.

OIL, GAS OR WATER RECORDS CASING RECORD

| FORMATION | CONTENT | FROM | TO | SIZE | PUT IN | PULLED OUT |
|-----------|---------|------|----|--------|--------|------------|
| | | | | 8 5/8" | 369' | None |
| | | | | | | |
| | | | | | | |
| | | | | | | |
| | | | | | | |
| | | | | | | |
| | | | | | | |

Describe in detail the manner in which the well was plugged, indicating where the mud fluid was placed and the method or methods used in introducing it into the hole. If cement or other plugs were used, state the character of same and depth placed, from _____ feet to _____ feet for each plug set.

Filled hole with heavy mud.
Spotted 35 sacks through Drill Pipe
@ 300'; mud to 40', solid bridge and
10 sacks to base of cellar; 2 sacks
in rathole.

RECEIVED
STATE CORPORATION COMMISSION
JUL 30 1974
CONSERVATION DIVISION
Wichita, Kansas


(If additional description is necessary, use BACK of this sheet)
Name of Plugging Contractor Sterling Drilling Company
Address P. O. Box 129, Sterling, Kansas 67579

STATE OF KANSAS, COUNTY OF RICE, ss.
F. A. Wuellner, (employee of owner) or (owner or operator) of the above-described

well, being first duly sworn on oath, says: That I have knowledge of the facts, statements, and matters herein contained and the log of the above-described well as filed and that the same are true and correct. So help me God. STERLING DRILLING COMPANY

(Signature) F. A. Wuellner
F. A. Wuellner, Secretary
P. O. Box 129, Sterling, Kansas 67579
(Address)

Subscribed and Sworn to before me this 22nd day of July, 19 74.
Charles M. Hall
Charles M. Hall, Notary Public.
My Commission Expires Jan. 6, 1978

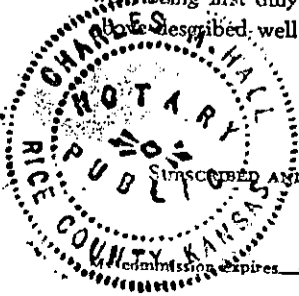

STERLING DRILLING COMPANY
P. O. Box 129
Sterling, Kansas 67579

WELL LOG ----- SPARKE #1
Located: NE SW SW, Section 9-27S-17W, Kiowa County, Kansas

OWNER: Holl - Sterling Drilling Company
ROTARY DRILLING CONTRACTOR: Sterling Drilling Company

COMMENCED: July 6, 1974
COMPLETED: July 18, 1974

TOTAL DEPTH: 4810'

| <u>LOG</u> | <u>CASING RECORD</u> |
|----------------------------|--|
| 0 - 145 Sand and Clay | Ran 11 joints 8 5/8" 24# casing, 357.34' |
| 145 - 320 Shale and Sand | cemented at 369' with 300 sacks common, 2% gel, 3% cc. Plug down at 8:30 PM, 7-6-74. |
| 320 - 535 Shale | |
| 535 - 1077 Red Bed - Sand | |
| 1077 - 1098 Anhydrite | |
| 1098 - 1345 Shale | |
| 1345 - 4085 Lime and Shale | |
| 4085 - 4725 Lime | |
| 4725 - 4810 Lime and Shale | Plugged. |

RECEIVED
STATE CORPORATION COMMISSION
JUL 30 1974
CONSERVATION DIVISION
Wichita, Kansas