

15-097-20392-0000


STATE OF KANSAS
STATE CORPORATION COMMISSION

WELL PLUGGING RECORD

Give All Information Completely
Make Required Affidavit
Mail or Deliver Report to
Conservation Division
State Corporation Comm.
245 North Water
Wichita, KS 67202

Kiowa County, Sec. 11 Twp. 27S Rge. 17W E/W
Location as "NE/CNW 1/4 SW 1/4" or footage from lines
C E/2 SE/4

Lease Owner Imperial Oil Company
Lease Name Long Well No. 1-11
Office Address 720 Fourth Financial Center, Wichita, Ks. 67202
Character of Well (Completed as Oil, Gas or Dry Hole) _____

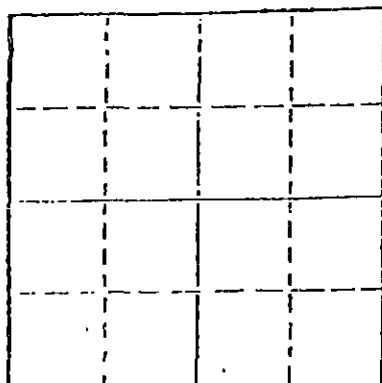

Locate well correctly on above
Section Plot

D & A
Date Well completed May 23, 1977
Application for plugging filed May 23, 1977
Application for plugging approved May 23, 1977
Plugging commenced May 23, 1977
Plugging completed May 23, 1977
Reason for abandonment of well or producing formation _____

D & A
If a producing well is abandoned, date of last production 19__

Was permission obtained from the Conservation Division or its agents before plugging was commenced? Yes

Name of Conservation Agent who supervised plugging of this well J. H. Metz
Producing formation _____ Depth to top _____ Bottom _____ Total Depth of Well 4750'
Show depth and thickness of all water, oil and gas formations.

OIL, GAS OR WATER RECORDS

CASING RECORD

FORMATION	CONTENT	FROM	TO	SIZE	PUT IN	PULLED OUT
				8 5/8"	448.50'	-0-

Describe in detail the manner in which the well was plugged, indicating where the mud fluid was placed and the method or methods used in introducing it into the hold. If cement or other plugs were used, state the character of same and depth placed, from _____ feet to _____ feet for each plug set.

Plugged w/35 sx cement @ 420'
Bridged hole @ 40' w/12 sx cement
5 sx cement in rathole

RECEIVED
STATE CORPORATION COMMISSION
JUN 23 1977
CONSERVATION DIVISION
Wichita, Kansas

6-23-77

(If additional description is necessary, use BACK of this sheet)

Name of Plugging Contractor Red Tiger Drilling Company
1720 KSB&T Building, Wichita, Kansas 67202


STATE OF Kansas COUNTY OF Sedwick, ss. contractor
Gloria Fawcett (employee of ~~xxxxxxx~~)
of the above-described well, being first duly sworn on oath, says: That I have knowledge of the facts, statements, and matters herein contained and the log of the above-described well as filed and that the same are true and correct. So help me God.

(Signature) Gloria Fawcett
1720 KSB&T Building, Wichita, Kansas 67202
(Address)

SUBSCRIBED AND SWORN TO before me this 31st day of May, 1977.

Joyce A. Hagermann
Notary Public.

My commission expires _____

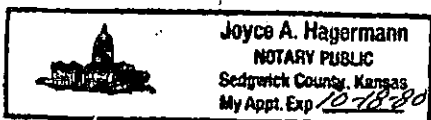

DRILLERS LOG

No. 1-11 Long

CASING RECORD:

COMPANY: Imperial Oil Company

DESCRIPTION:

8 5/8" @ 445'
w/300 sx cement

CONTRACTOR: Red Tiger Drilling Company

C E/2 SE/4
Sec. 11-T27S-R17W
Kiowa County, Kansas

COMMENCED: May 12, 1977

COMPLETED: May 23, 1977

TOTAL DEPTH: 4,750'

ELEVATION: 2,134' KB

<u>FORMATION</u>	<u>FROM</u>	<u>TO</u>	<u>REMARKS</u>
Sand	0	450	
Shale	450	1065	
Anhydrite	1065	1095	
Shale	1095	2105	
Shale & Lime	2105	2400	
Lime	2400	2625	
Lime & Shale	2625	2950	
Lime	2950	2990	
Lime & Shale	2990	3330	
Lime	3330	4750	
RTD		4750	


I certify that this is a true and correct copy of the above log to the best of my knowledge.

RED TIGER DRILLING COMPANY

Gloria Fawcett
Gloria Fawcett

Subscribed and sworn to before me this 31st day of May, 1977.

Joyce A. Hagermann
Notary Public

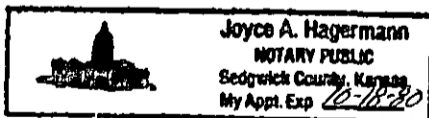

RECEIVED
STATE CORPORATION COMMISSION

JUN 03 1977

CONSERVATION DIVISION
Wichita, Kansas