


STATE OF KANSAS  
STATE CORPORATION COMMISSION

WELL PLUGGING RECORD

Give All Information Completely  
Make Required Affidavit  
Mail or Deliver Report to  
Conservation Division  
State Corporation Comm.  
245 North Water  
Wichita, KS 67202

Kiowa County. Sec. 13 Twp. 27S Rge. 17W E/W  
Location as "NE/CNW $\frac{1}{4}$ SW $\frac{1}{4}$ " or footage from lines  
C of NW NE

Lease Owner Imperial Oil Company  
Lease Name Long Well No. #1-13  
Office Address 720 Fourth National Center Wichita, Ks 67202  
Character of Well (Completed as Oil, Gas or Dry Hole) \_\_\_\_\_

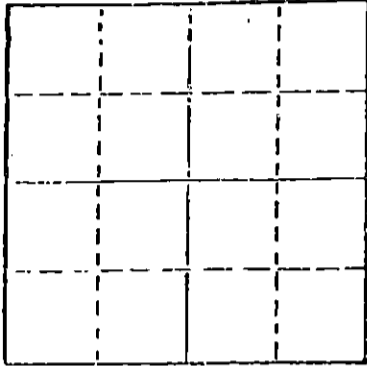

Locate well correctly on above  
Section Plot

Date Well completed \_\_\_\_\_ 19\_\_\_\_  
Application for plugging filed \_\_\_\_\_ 19\_\_\_\_  
Application for plugging approved \_\_\_\_\_ 19\_\_\_\_  
Plugging commenced \_\_\_\_\_ 9-1-81 \_\_\_\_\_ 19\_\_\_\_  
Plugging completed \_\_\_\_\_ 9-4-81 \_\_\_\_\_ 19\_\_\_\_  
Reason for abandonment of well or producing formation \_\_\_\_\_

Depleted  
If a producing well is abandoned, date of last production \_\_\_\_\_ 19\_\_\_\_

Was permission obtained from the Conservation Division or  
its agents before plugging was commenced? yes

Name of Conservation Agent who supervised plugging of this well Maurice Leslie  
Producing formation \_\_\_\_\_ Depth to top \_\_\_\_\_ Bottom \_\_\_\_\_ Total Depth of Well 4685'  
Show depth and thickness of all water, oil and gas formations.

OIL, GAS OR WATER RECORDS

CASING RECORD

FORMATION	CONTENT	FROM	TO	SIZE	PUT IN	PULLED OUT
				8-5/8"	440'	none
				4-1/2"	4684'	2418'

Describe in detail the manner in which the well was plugged, indicating where the mud fluid was placed and the method or methods used in introducing it into the hold. If cement or other plugs were used, state the character of same and depth placed, from \_\_\_\_\_ feet to \_\_\_\_\_ feet for each plug set.

Moved in on location, ran sand to 4550' and set 4 sacks cement, pulled 19" tension. Shot pipe @3455', 3210', 3010', 2845', 2710', 2620', 2510' and 2410'. Pulled 72 joints of pipe. Plugged well with 15 sacks gel, 6 sacks hulls, 10 sacks gel, 8-5/8" plug, and 150 sacks 50/50 pos, 4% gel, 3% cc. Plugging completed.

9-9-81

RECEIVED  
STATE CORPORATION COMMISSION

SEP - 9 1981  
CONSERVATION DIVISION  
Wichita, Kansas

(If additional description is necessary, use BACK of this sheet)  
Name of Plugging Contractor Kelso Casing Pulling

STATE OF Kansas COUNTY OF Rice  
R. Darrell Kelso (employee of owner) or (owner or operator)

of the above-described well, being first duly sworn on oath, says: That I have knowledge of the facts, statements, and matters herein contained and the log of the above-described well as filed and that the same are true and correct. So help me God.

(Signature) R. Darrell Kelso  
R. Darrell Kelso  
(Address)

SUBSCRIBED AND SWORN TO before me this 8th day of September, 19 81

My commission expires



Irene Hoover  
Notary Public.