


STATE OF KANSAS
STATE CORPORATION COMMISSION
Give All Information Completely
Make Required Affidavit
Mail or Deliver Report to:
Conservation Division
State Corporation Commission
211 No. Broadway
Wichita, Kansas

WELL PLUGGING RECORD

Kiowa County. Sec. 36 Twp. 27S Rge. 20W (E) (W)
Location as "NE/CNW/SW" or footage from lines C NE/4 NE/4
Lease Owner Walters Drilling Co.
Lease Name McDonald Well No. 1
Office Address 510 Orpheum Building, Wichita, Kansas
Character of Well (completed as Oil, Gas or Dry Hole) Dry Hole
Date well completed September 26th 19 62
Application for plugging filed _____ 19 _____
Application for plugging approved _____ 19 _____
Plugging commenced September 26th 19 62
Plugging completed September 26th 19 62
Reason for abandonment of well or producing formation _____

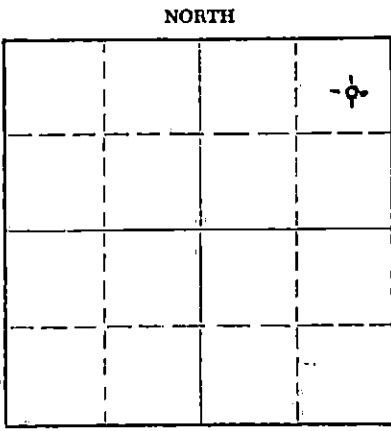

Locate well correctly on above Section Plat

If a producing well is abandoned, date of last production _____ 19 _____
Was permission obtained from the Conservation Division or its agents before plugging was commenced? Yes

Name of Conservation Agent who supervised plugging of this well W. L. Lackamp
Producing formation Mississippian Depth to top _____ Bottom _____ Total Depth of Well 4975 Feet
Show depth and thickness of all water, oil and gas formations.

OIL, GAS OR WATER RECORDS

CASING RECORD

FORMATION	CONTENT	FROM	TO	SIZE	PUT IN	PULLED OUT
				8-5/8"	351'	-0-

Describe in detail the manner in which the well was plugged, indicating where the mud fluid was placed and the method or methods used in introducing it into the hole. If cement or other plugs were used, state the character of same and depth placed, from _____ feet to _____ feet for each plug set.

Set bottom plug @ 320' with hulls and 20 sacks cement.
Set top plug @ 35' with hulls and 10 sacks cement.
Job complete @ 4:30 P.M. on 9-26-62.

RECEIVED
STATE CORPORATION COMMISSION
10-3-62 OCT 3 1962
CONSERVATION DIVISION
Wichita, Kansas

(If additional description is necessary, use BACK of this sheet)
Name of Plugging Contractor Walters Drilling Co.,
Address 510 Orpheum Building, Wichita, Kansas

STATE OF KANSAS, COUNTY OF Sedgwick, ss.
Robert F. Walters (signature) or (owner or operator) of the above-described well, being first duly sworn on oath, says: That I have knowledge of the facts, statements, and matters herein contained and the log of the above-described well as filed and that the same are true and correct. So help me God.
(Signature) Robert F. Walters
ROBERT F. WALTERS, Partner
510 Orpheum Building, Wichita, Kansas
(Address)

SUBSCRIBED AND SWORN to before me this 1st day of October, 19 62

My commission expires January 4th, 1964.
R. L. Abel
R. L. Abel, Notary Public.

McDONALD #1

LOCATION: C NE/4 NE/4 Section 36-27S-20W
Kiowa County, Kansas

OPERATOR: Walters Drilling Co.

CONTRACTOR: Walters Drilling Co.

SURFACE CASING: 8-5/8" @ 351' w/300 sacks cement

OIL STRING: None

DATE COMMENCED: 9-10-62

DATE SPUDDED: 9-12-62

ROTARY COMPLETION: 9-26-62

ELEVATION: 2275 GL
2277 DF
2280 KB

L O G
(Figures indicate bottom of formation)

Sand	0-105'
Shale & Shells	674'
Blaine lime	698'
Shale & Red Bed	1254'
Anhydrite	1280'
Shale & Shells	1875'
Shale & Lime	2525'
Lime	2905'
Lime & Shale	3504'
Lime	3545'
Lime & Shale	3745'
Lime	3840'
Lime & Shale	3895'
Lime	3980'
Lime & Shale	4245'
Lime	4500'
Lime & Shale	4556'
Lime	4642'
Lime & Shale	4870'
Chert	4905'
Lime & Chert	4915'
Lime	4975'
Total Depth	4975'


RECEIVED
STATE CORPORATION COMMISSION
OCT 3 1962
CONSERVATION DIVISION
Wichita, Kansas

The undersigned, Robert F. Walters, hereby certifies that the above log is a true and correct log of the formations encountered in drilling the above noted well as reflected by the Daily Drilling Reports.

BY:


ROBERT F. WALTERS, Partner

Subscribed and sworn to before me
this 1st day of October, 1962.


R. L. Abel, Notary Public

My commission expires January 4th, 1964.