


STATE OF KANSAS
STATE CORPORATION COMMISSION

Form CP-4

WELL PLUGGING RECORD

Give All Information Completely
Make Required Affidavit
Mail or Deliver Report to:
Conservation Division
State Corporation Commission
212 No. Market
Wichita, Kansas

NORTH

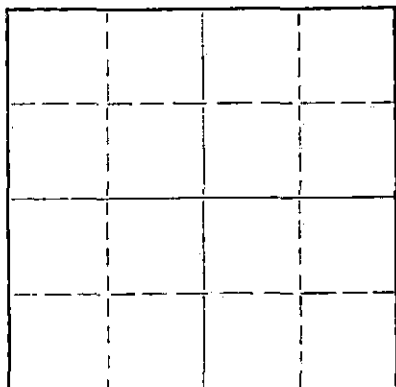

Locate well correctly on above
Section Plat

Kiowa County. Sec. 23 Twp. 27 Rge. 20 (E) W (W)
Location as "NE/CNW/SW" or footage from lines C NE NW
Lease Owner Rains & Williamson Oil Company
Lease Name Bowers Well No. 1
Office Address Wichita, Kansas
Character of Well (completed as Oil, Gas or Dry Hole) _____
Date well completed _____ 19____
Application for plugging filed _____ 19____
Application for plugging approved _____ 19____
Plugging commenced 8-25-66 _____ 19____
Plugging completed 8-31-66 _____ 19____
Reason for abandonment of well or producing formation Depleted.

If a producing well is abandoned, date of last production _____ 19____
Was permission obtained from the Conservation Division or its agents before plugging was commenced? yes

Name of Conservation Agent who supervised plugging of this well Archie Elving
Producing formation _____ Depth to top _____ Bottom _____ Total Depth of Well 4858 Feet
Show depth and thickness of all water, oil and gas formations.

OIL, GAS OR WATER RECORDS

CASING RECORD

FORMATION	CONTENT	FROM	TO	SIZE	PUT IN	PULLED OUT
				8-5/8"	344'	None
				5-1/2"	4847'	3618'

Describe in detail the manner in which the well was plugged, indicating where the mud fluid was placed and the method or methods used in introducing it into the hole. If cement or other plugs were used, state the character of same and depth placed, from _____ feet to _____ feet for each plug set.

Checked hole to 4858', sanded hole to 4825' and dumped 5 sacks of cement @ 4825' with dump bailer. Pulled 5 1/2" casing, bailed fluid to 145', set rock bridge ~~to 300'~~ from 300' to 290' and dumped 5 sacks of cement with calcium chloride. Let set for 2 hrs. and bailed fluid down and dumped 20 sacks of cement. Mudded hole to 40', set rock bridge to 30' and ran 10 sacks of cement to base of cellar.

RECEIVED
STATE CORPORATION COMMISSION

SEP 9 1966

CONSERVATION DIVISION
Wichita, Kansas

PLUGGING COMPLETE.

(If additional description is necessary, use BACK of this sheet)
Name of Plugging Contractor KNIGHT CASING PULLING COMPANY
Address CHASE, KANSAS

STATE OF KANSAS, COUNTY OF RICE, ss.
Noel J. Knight (employee of owner) or (~~owner or contractor~~) of the above-described well, being first duly sworn on oath, says: That I have knowledge of the facts, statements, and matters herein contained and the log of the above-described well as filed and that the same are true and correct. So help me God.

(Signature) Noel J. Knight
Chase, Kansas
(Address)

SUBSCRIBED AND SWORN TO before me this 6th day of September, 1966

My commission expires May 20, 1968

Milton J. Volin
Notary Public.


WELL LOG BUREAU—KANSAS GEOLOGICAL SOCIETY
508 East Murdock, Wichita, Kansas

Company- BEARDMORE DRILLING CO.
Farm- Bowers No. 1

SEC. 23 T. 27 R. 20W
C NE NW

Total Depth. 4858'
Comm. 10-20-61 Comp. 11-6-61
Shot or Treated.
Contractor. Gebbert-Jones Drlg. Co.
Issued. 3-10-62

County Kiowa KANSAS

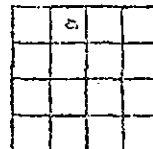

Elevation. 2299' RB

Production. 108 BOPD

CASING:

3 5/8" 344' cem w/225 sx.
5 1/2" 4847' cem w/75 sx.

Figures Indicate Bottom of Formations.

sand	120
sand & clay	295
shale	345
shale	705
Anhydrite	725
shale, shells & redbed	900
red bed	1285
shale & shells	2375
lime	2585
lime & shale	3642
lime	3855
lime & shale	3955
lime	4858
Total Depth	

TOPS: SCOUT

Heubner	4070
Brown Line	4212
Lansing	4219
Cherokee	4751
Mississippi	4812

RECEIVED
STATE CORPORATION COMMISSION
JUL 27 1966
CONSERVATION DIVISION
Wichita, Kansas