


STATE OF KANSAS
STATE CORPORATION COMMISSION

Form CP-4

Give All Information Completely
Make Required Affidavit
Mail or Deliver Report to:
Conservation Division
State Corporation Commission
P. O. Box 17027
Wichita, Kansas 67217
NORTH

WELL PLUGGING RECORD

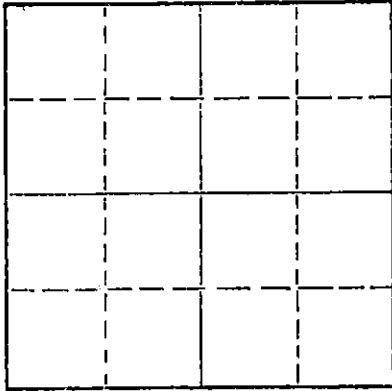

Locate well correctly on above
Section Plat

_____ Kiowa _____ County. Sec. 24 Twp. 27S Rge. XEX 20(W)
Location as "NE/CNW/SW" or footage from lines C SE SE
Lease Owner Pickrell Drilling Company
Lease Name Zimmerman "F" Well No. 1
Office Address 705 Fourth National Bank Bldg., Wichita, Kansas 67202
Character of Well (completed as Oil, Gas or Dry Hole) Dry Hole
Date well completed December 22 19 72
Application for plugging filed December 22 19 72
Application for plugging approved December 22 19 72
Plugging commenced December 22 19 72
Plugging completed December 22 19 72
Reason for abandonment of well or producing formation Dry Hole

If a producing well is abandoned, date of last production 19____
Was permission obtained from the Conservation Division or its agents before plugging was commenced? Yes

Name of Conservation Agent who supervised plugging of this well Archie V. Elving
Producing formation _____ Depth to top _____ Bottom _____ Total Depth of Well 4920 Feet
Show depth and thickness of all water, oil and gas formations.

OIL, GAS OR WATER RECORDS

CASING RECORD

FORMATION	CONTENT	FROM	TO	SIZE	PUT IN	PULLED OUT
				8-5/8"	342'	NONE

Describe in detail the manner in which the well was plugged, indicating where the mud fluid was placed and the method or methods used in introducing it into the hole. If cement or other plugs were used, state the character of same and depth placed, from _____ feet to _____ feet for each plug set.

Bottom Plug @ 300' w/35 sacks, Top Plug @ 40' w/15 Sacks.


RECEIVED
STATE CORPORATION COMMISSION
DEC 29 1972
CONSERVATION DIVISION
Wichita, Kansas

(If additional description is necessary, use BACK of this sheet)
Name of Plugging Contractor Pickrell Drilling Company
Address 705 Fourth National Bank Building, Wichita, Kansas 67202

STATE OF Kansas, COUNTY OF Sedgwick, ss.
C. W. Sebits (employee of owner) or (owner or operator) of the above-described well, being first duly sworn on oath, says: That I have knowledge of the facts, statements, and matters herein contained and the log of the above-described well as filed and that the same are true and correct. So help me God.

(Signature) C. W. Sebits
705 Fourth National Bank Bldg., Wichita, Kansas (Address)

Subscribed and sworn to before me this 27th day of December, 1972

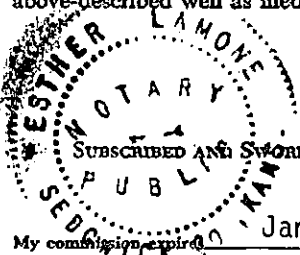

Esther Lamone
Notary Public.

My commission expires January 19, 1973

ROTARY DRILLING LOG

COMPANY: Pickrell Drilling Company
705 Fourth National Bank Building
Wichita, Kansas 67202

Rotary Drilling Commenced 12/10/72

Rotary Drilling Completed 12/22/72

LOCATION: Zimmerman "F" No. 1, C SE SE Sec. 24-27S-20W
Kiowa County, Kansas

CONTRACTOR: **PICKRELL DRILLING COMPANY**
Wichita, Kansas

CASING RECORD: Run 8 Jts. 8-5/8" surface casing set @ 342' KB. Cemented w/200 sacks: Completed 5:00 P.M. Circulated.

No oil string run. D & A. Plugged down 9:45 P.M. December 22, 1972.

LOG

(Figures indicate bottom of formation — measurements from top of rotary bushing.)

190	Sand	C.F.S.
265	Shale	4245
280	Sand	4274
515	Shale	4415
650	Sand	4825
670	Shale	4837
700	Blaine	4850
990	Shale & Red Beds	4868
1254	Red Beds - Shale	4873
1281	Anhydrite	4858
1735	Shale - Shells	4900
2300	Shale	4920
2360	Lime & Shale	
2955	Lime	
4190	Lime & Shale	
4220	Shale & Lime	
4815	Lime	S.L.M.
4850	Lime & Chert	
4858	Mississippian	Board 4609.23
4868	Lime	Strap 4607.52
4873	Miss. Lime	1.71 Difference
4920	Miss., RTD	No Correction

RECEIVED
STATE CORPORATION COMMISSION
DEC 29 1972
CONSERVATION DIVISION
Wichita, Kansas

Slope Tests

2000
2500
3000
3500
4000
4500

The undersigned, C. W. Sebitts, Attorney-in-Fact for PICKRELL DRILLING COMPANY, hereby certifies in behalf of said Company, that the above is a true and correct log of the formation encountered in drilling the above well as reflected by the Daily Drilling Reports.

PICKRELL DRILLING COMPANY
By [Signature]
C. W. Sebitts Attorney-in-Fact

STATE OF KANSAS }
COUNTY OF SEDGWICK } ss.:

On this 27th day of December, 19 72, before me the undersigned, a Notary Public, in and for the County and State aforesaid, personally appeared C. W. Sebitts, to me known to be the identical person who subscribed the name of PICKRELL DRILLING COMPANY to the foregoing instrument as its Attorney-in-Fact, and acknowledged to me that he executed the same as his free and voluntary act and deed, and as the free and voluntary act and deed of such company, for the uses and purposes therein set forth.

Given under my hand and seal of office the day and year last above written.

My commission expires: January 19, 1973

[Signature]
Esther Lamone Notary Public

