

STATE OF KANSAS
STATE CORPORATION COMMISSION


Give All Information Completely
Make Required Affidavit
Mail or Deliver Report to:
Conservation Division
State Corporation Commission
211 No. Broadway
Wichita, Kansas

WELL PLUGGING RECORD

Kiowa County, Sec. 22 Twp. 27S Rge. (E) 20 (W)

Location as "NE/CNW/SW" or footage from lines C SE NW
Lease Owner Falcon Seaboard Drilling Company
Lease Name Robbins Well No. 1
Office Address Pan American Building, Tulsa, Oklahoma
Character of Well (completed as Oil, Gas or Dry Hole) Dry Hole
Date well completed May 30, 19 61
Application for plugging filed May 30, 19 61
Application for plugging approved May 30, 19 61
Plugging commenced May 31, 19 61
Plugging completed May 31, 19 61
Reason for abandonment of well or producing formation _____

NORTH

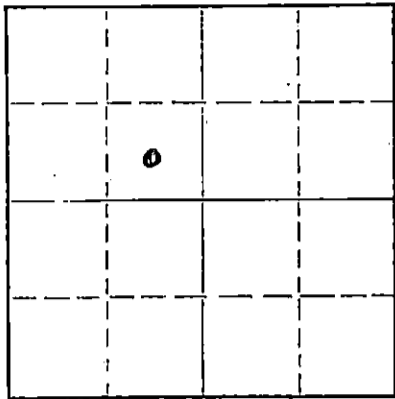

Locate well correctly on above
Section Plat

If a producing well is abandoned, date of last production _____ 19____
Was permission obtained from the Conservation Division or its agents before plugging was commenced? Yes

Name of Conservation Agent who supervised plugging of this well Frank Broadfoot
Producing formation _____ Depth to top _____ Bottom _____ Total Depth of Well 4981 Feet
Show depth and thickness of all water, oil and gas formations.

OIL, GAS OR WATER RECORDS

CASING RECORD

FORMATION	CONTENT	FROM	TO	SIZE	PUT IN	PULLED OUT
				8-5/8"	405	none

Describe in detail the manner in which the well was plugged, indicating where the mud fluid was placed and the method or methods used in introducing it into the hole. If cement or other plugs were used, state the character of same and depth placed, from _____ feet to _____ feet for each plug set.

Set 20 sack cement plug @ 240'; 10 sack cement plug @ 35' and welded steel cap on top of 8-5/8" casing.

RECEIVED
STATE CORPORATION COMMISSION
6-13-61
JUN 13 1961
CONSERVATION DIVISION
Wichita, Kansas

(If additional description is necessary, use BACK of this sheet)
Name of Plugging Contractor Prime Drilling Company
Address Wichita, Kansas


STATE OF OKLAHOMA, COUNTY OF TULSA, ss.
J. O. Brown (employee of owner) or (owner or operator) of the above-described well, being first duly sworn on oath, says: That I have knowledge of the facts, statements, and matters herein contained and the log of the above-described well as filed and that the same are true and correct. So help me God.

(Signature) J. O. Brown
805 Pan American Building, Tulsa, Oklahoma

SUBSCRIBED AND SWORN TO before me this 7th day of June, 19 61

My commission expires April 6, 1963

Kathryne Donohoo
Notary Public.

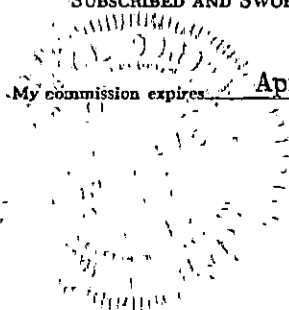

ROTARY DRILLING LOG

OPERATOR: Falcon Seaboard Drilling Company
 Robbins No. 1
 C SE NW Sec. 22-27S-20W
 Kiowa County, Kansas

CONTRACTOR: Prime Drilling Company
 COMM: 5/12/61
 COMP: 5/31/61

Remarks: Set 8-5/8" casing at 405'
 cemented with 275 sacks
 HA-5 Pozmix.

Formations:

Clay	35'
Sand	353'
Shale	650'
Red Bed	840'
Shale	1405'
Shale & Shells	2110'
Shale & Lime	2335'
Lime	2955'
Lime & Shale	3235'
Lime	3310'
Lime & Shale	3959'
Lime	4930'
Cherty Lime	4978'
Lime	4981'

Rotary Total Depth (D&A) 4981'

RECEIVED
 STATE CORPORATION COMMISSION

JUN 13 1961

CONSERVATION DIVISION
 Wichita, Kansas

We certify the above log is true and
 correct to the best of our knowledge
 and belief.

PRIME DRILLING COMPANY

R. R. McNicol

R. R. McNicol