


STATE OF KANSAS
STATE CORPORATION COMMISSION

Form CP-4

WELL PLUGGING RECORD

Give All Information Completely
Make Required Affidavit
Mail or Deliver Report to:
Conservation Division
State Corporation Commission
212 No. Market
Wichita, Kansas

NORTH

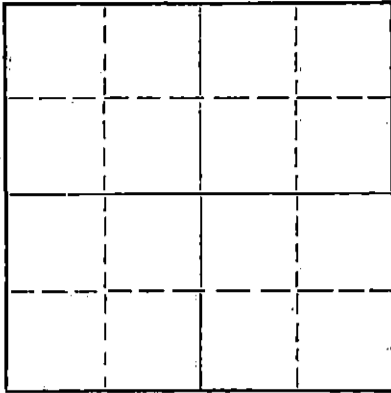

Locate well correctly on above
Section Plot

Kingman County. Sec. 19 Twp. 27S Rge. 10 (E) (W) X
Location as "NE/CNW/SW" or footage from lines SW SE SW

Lease Owner Skelly Oil Company
Lease Name Cunningham Unit Well No. B-6
Office Address Cunningham, Kansas
Character of Well (completed as Oil, Gas or Dry Hole)
Date, well completed 19
Application for plugging filed 19
Application for plugging approved 19
Plugging commenced 9-16 19 66
Plugging completed 9-28 19 66
Reason for abandonment of well or producing formation

If a producing well is abandoned, date of last production 19
Was permission obtained from the Conservation Division or its agents before plugging was commenced? Yes

Name of Conservation Agent who supervised plugging of this well Mr. Justice
Producing formation Depth to top Bottom Total Depth of Well 3579 Feet
Show depth and thickness of all water, oil and gas formations.

OIL, GAS OR WATER RECORDS

RECEIVED

CASING RECORD

FORMATION	CONTENT	SIZE	PUT IN	PULLED OUT
		12 1/2	323	None
		7	None	2497

CONSERVATION DIVISION
Wichita, Kansas

Describe in detail the manner in which the well was plugged, indicating where the mud fluid was placed and the method or methods used in introducing it into the hole. If cement or other plugs were used, state the character of same and depth placed, from feet to feet for each plug set.

Moved in unit. Rigged up unit. Sanded back bottom from 3579' to 3380'. Checked sand with S.L.M. - top at 3360'.

Hauled 25 sacks of cement from Kingman, Kansas and dumped same on sand bridge at 3360'.

Cut down trees around well. Dug cellar. Unpacked braden head. Rigged up jacks. Working pipe. Checked cement with Howco line - top at 3220'. Working pipe - 1 1/2" tension. Shot pipe at 2500'.

Pulling pipe - laid down 300'. Laid down 900'. Well blew out saltwater - still gasing. Pulling pipe. Rigged up pump to circulate mud. Pumped 25 sacks of gel mud at 1300' - didn't circulate - took 150# to pump into well - final pressure 75#. Pulling pipe - pipe breaking hard.

Tried to bail hole down - wouldn't bail down. Set overnight bridge at 323'. Build 10' rock bridge with 10 sacks of cement - mixed and dumped with bailer. Finished pulling pipe.

Bailed hole down on overnight bridge. Mixed and dumped 25 sacks on bottom. Mudded hole to 40'. Set 10' rock bridge with 15 sacks.

(If additional description is necessary, use BACK of this sheet)

Name of Plugging Contractor Forbes Casing Pulling, Inc.
Address P. O. Box 221 Great Bend, Kansas

STATE OF Kansas, COUNTY OF Barton, ss.
J. O. Forbes

(employee of owner) or (owner or operator) of the above-described well, being first duly sworn on oath, says: That I have knowledge of the facts, statements, and matters herein contained and the log of the above-described well as filed and that the same are true and correct. So help me God.

(Signature) J. O. Forbes
P. O. Box 221 Great Bend, Kansas
(Address)

SUBSCRIBED AND SWORN to before me this 11 day of October 19 66

My commission expires May 27, 1969

Notary Public.