

STATE OF KANSAS
STATE CORPORATION COMMISSION

WELL PLUGGING RECORD


Give All Information Completely
Make Required Affidavit
Mail or Deliver Report to:
Conservation Division
State Corporation Commission
320 Bittling Building
Wichita, Kansas

OR

FORMATION PLUGGING RECORD

Strike out upper line
when reporting plugging
off formations.

NORTH

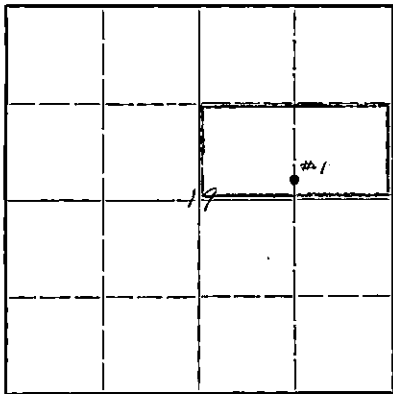

Locate well correctly on above
Section Plat

Kingman County. Sec. 19 Twp. 27S Rge. (E) 10 (W)
Location as "NE 1/4 NW 1/4 SW 1/4" or footage from lines 330' from S line & 1320'
Lease Owner Skelly Oil Company from East line of NE 1/4
Lease Name Miles "D" Well No. 1
Office Address Box 391, Hutchinson, Kansas
Character of Well (completed as Oil, Gas or Dry Hole) Oil
Date well completed March 31, 19 39
Application for plugging filed August 22, 19 46
Application for plugging approved September 6, 19 46
Plugging commenced August 21, 19 46
Plugging completed August 29, 19 46
Reason for abandonment of well or producing formation Depleted oil well

If a producing well is abandoned, date of last production February 1 19 46
Was permission obtained from the Conservation Division or its agents before plugging was commenced? Yes

Name of Conservation Agent who supervised plugging of this well Ruel Durkee
Producing formation Simpson Sand Depth to top 4154' Bottom 4168' Total Depth of Well 4168 Feet
Show depth and thickness of all water, oil and gas formations.

OIL, GAS OR WATER RECORDS

CASING RECORD

Formation	Content	From	To	OD Size	Put In	Pulled Out
Lansing Lime	Oil	3494'	3504'	10-3/4"	380' 5"	None
Viola Lime	Gas	4058'	4070'	7"	3513' 8"	2259' 3"
Simpson Sand	Gas	4154'	4168'	4 1/2"	4082' 9"	3199' 1"

Describe in detail the manner in which the well was plugged, indicating where the mud fluid was placed and the method or methods used in introducing it into the hole. If cement or other plugs were used, state the character of same and depth placed, from.....feet to.....feet for each plug set.

See attached remarks covering plugging back to 3638'
6 sacks of cement 3638' to 3566'
Mud laden fluid 3566' to 300'
Wood plug and 15 sacks cement 300' to 73'
Mud laden fluid 73' to 20'
Wood plug & 10 sacks cement 20' to 6'
Surface soil 6' to 0'

PLUGGING
FILE 19-27-10-2
BOOK PAGE 68 LINE 2-2

STATE CORPORATION COMMISSION
SEP 14 1946

(If additional description is necessary, use BACK of this sheet)
Correspondence regarding this well should be addressed to Skelly Oil Company
Address Box 391, Hutchinson, Kansas

STATE OF KANSAS, COUNTY OF RENO, ss.
H. E. Wamsley (employee of owner or CONSERVATION DIVISION of the above-described well,
being first duly sworn on oath, says: That I have knowledge of the facts, statements, and matters herein contained and the log of the above-described well as filed and that the same are true and correct. So help me God.

(Signature) [Signature]
Box 391, Hutchinson, Kansas (Address)

SUBSCRIBED AND SWORN TO before me this 13th day of September, 19 46

My commission expires April 7, 1947 [Signature] Notary Public.