


STATE OF KANSAS
STATE CORPORATION COMMISSION

WELL PLUGGING RECORD

Give All Information Completely
Make Required Affidavit
Mail or Deliver Report to
Conservation Division
State Corporation Comm.
245 North Water
Wichita, KS 67202

Kingman County. Sec. 19 Twp. 27S Rge. 10 ~~XX~~W
Location as "NE/CNW $\frac{1}{4}$ SW $\frac{1}{4}$ " or footage from lines
330' from S. Line & 1320' from E. Line of NE/4

Lease Owner Northern Natural Gas Company
Lease Name Miles Well No. D-1
Office Address P.O. Box 88, Lyons, Kansas 67554
Character of Well (Completed as Oil, Gas or Dry Hole)

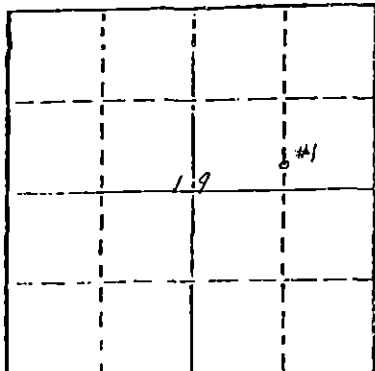

Locate well correctly on above
Section Plot

Oil
Date Well completed March 31, 1939
Application for plugging filed N/A 19
Application for plugging approved N/A 19
Plugging commenced March 18, 1981
Plugging completed April 27, 1981
Reason for abandonment of well or producing formation
Depleted oil well
If a producing well is abandoned, date of last production
February 1, 1946

Was permission obtained from the Conservation Division or
its agents before plugging was commenced? Yes verbal with
F. Broadfoot

Name of Conservation Agent who supervised plugging of this well Morris Leslie
Producing formation Simpson Sand Depth to top 4154' Bottom 4168' Total Depth of Well 4168'
Show depth and thickness of all water, oil and gas formations.

OIL, GAS OR WATER RECORDS

CASING RECORD

FORMATION	CONTENT	FROM	TO	SIZE	PUT IN	PULLED OUT
Lansing Lime	Oil - Depleted	3491'	3504'	10-3/4"	380'5"	None
Viola Lime	Gas "	4058'	4070'	7"	3513'8"	2259'3"
Simpson Sand	Gas "	4154'	4168'	4-1/2"	4082'9"	3199'1"

Describe in detail the manner in which the well was plugged, indicating where the mud fluid
was placed and the method or methods used in introducing it into the hold. If cement or other
plugs were used, state the character of same and depth placed, from _____ feet to
_____ feet for each plug set.

Halliburton pumped: 55 sks. 50-50 poz-mix from 4120' to 3400'
45 sks. 50-50 poz-mix from 380' to 280'
20 sks. 50-50 poz-mix from 40' to base of cellar.
Rat hole and mouse hole plugged w/ 5 sks. each.

RECEIVED
STATE CORPORATION COMMISSION

(If additional description is necessary, use BACK of this sheet)

Name of Plugging Contractor Halliburton

MAY - 6 1991

STATE OF KANSAS COUNTY OF Rice CONSERVATION DIVISION
Wichita, Kansas

Paul B. Horsch (employee of owner) or ~~(owner or operator)~~
of the above-described well, being first duly sworn on oath, says: That I have knowledge of
the facts, statements, and matters herein contained and the log of the above-described well
as filed and that the same are true and correct. So help me God.

(Signature) Paul B. Horsch
PO Box 88, Lyons, Kansas 67554
(Address)

SUBSCRIBED AND SWORN TO before me this 5th day of May, 1981

My commission expires 11-18-81

Jalayne D. Young
Notary Public.

