


STATE OF KANSAS
STATE CORPORATION COMMISSION
Give all Information Completely
Make Required Affidavit
Mail or Deliver Report to:
Conservation Division
State Corporation Commission
800 Bittling Building
Wichita, Kansas

WELL PLUGGING RECORD

Pratt County. Sec. 6 Twp. 27 Rge. 12 (E) (W)

Location as "NE/CNW $\frac{1}{4}$ SW $\frac{1}{4}$ " or footage from lines NE NW SW
Lease Owner Cooperative Refinery Association
Lease Name Beck "A" Well No. 1
Office Address Box 765 - Great Bend, Kansas
Character of Well (completed as Oil, Gas or Dry Hole) Dry Hole
Date well completed December 10 1952
Application for plugging filed October 5 1953
Application for plugging approved October 6 1953
Plugging commenced October 6 1953
Plugging completed October 16 1953
Reason for abandonment of well or producing formation Dry Hole

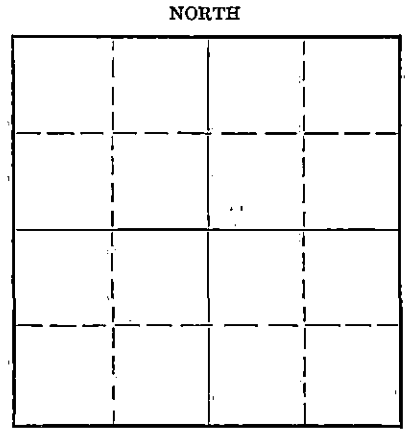

Locate well correctly on above Section Plat

If a producing well is abandoned, date of last production 19...
Was permission obtained from the Conservation Division or its agents before plugging was commenced? Yes

Name of Conservation Agent who supervised plugging of this well M. A. Rives
Producing formation Depth to top Bottom Total Depth of Well 1,281.3 Feet
Show depth and thickness of all water, oil and gas formations.

OIL, GAS OR WATER RECORDS

CASING RECORD

Formation	Content	From	To	Size	Put In	Pulled Out

Describe in detail the manner in which the well was plugged, indicating where the mud fluid was placed and the method or methods used in introducing it into the hole. If cement or other plugs were used, state the character of same and depth placed, from feet to feet for each plug set.

1005 Top Baker plug set
1005' to 3820' Chat
3820' to 3785' Cement 5 sacks
3785' to 373' Mudded
373' to Bottom of cellar - cement 100 sacks

Mudded and cemented with Halliburton

(If additional description is necessary, use BACK of this sheet)

Name of Plugging Contractor Betts Oil Field Service
Address Russell, Kansas

STATE OF Kansas, COUNTY OF Barton, ss.
Guinn L. Simmons (employee of owner) or (owner or operator) of the above-described well,
being first duly sworn on oath, says: That I have knowledge of the facts, statements, and matters herein contained and the log of the above-described well as filed and that the same are true and correct. So help me God.

(Signature) *G L Simmons*

Box 765 - Great Bend, Kansas (Address)

SUBSCRIBED AND SWORN TO before me this 21st day of October, 1953.

My commission expires August 17, 1957

23-8390-s 6-51-20M

PLUGGING
FILE SEC 6 T 27 R 12W
BOOK PAGE 133 LINE 42

RECEIVED
STATE CORPORATION COMMISSION
Notary Public.
OCT 22 1953 10-22-53
DIVISION

COOPERATIVE REFINERY ASS'N

Great Bend, Kansas

Company: Cooperative Refinery Ass'n.
 Farm: Beck "A" #4
 Comm: 11-19-52
 Comp: 12-9-52
 Contractor: Company Tools

Sec: 6-27-12W
 Loc: NW NE NW
 Pratt County, Kansas
 Elevation: 1878' D.F.

0	40	Surface	
40	170	Sand	
170	415	Shale Shells & red bed	
415	455	Red bed & shale	
455	740	Shale shells & red bed	
740	755	Anhydrite	
755	1185	Shale & shells	
1185	1425	Salt, shale & shells	
1425	1720	Shale & shells	Cemented 8-5/8" casing at
1720	1905	Shale & lime	455' with 300 sacks of
1905	2230	Lime & shale	posmix & 2 sacks C.C.
2230	2330	Lime	
2330	2695	Lime & shale	
2695	2930	Shale & lime	
2930	3290	Lime	
3290	3390	Lime & shale	
3390	3415	Shale & lime	
3415	3490	Lime	
3490	3680	Shale & lime	
3680	3750	Lime	
3750	3785	Lime & shale	
3785	4110	Lime	
4110	4165	Lime & chert	Cemented 5 1/2" casing at
4165	4200	Cherty lime	4280 with 100 sacks cement.
4200	4285	Lime T.D.	

I hereby certify that this is the true and correct copy of the above log, to the best of my knowledge.

L. M. Callan

Subscribed and sworn to before me this 15th day of December 1952.

Walter Lee Doherty
 Notary Public

My commission expired: 9-15-56

PLUGGING
 FILE SEC 6 T22 R 2W
 BOOK PAGE 133 LINE 42

RECEIVED
 STATE CORPORATION COMMISSION
 NOV 17 1952
 CONSERVATION DIVISION
 Wichita, Kansas