


STATE OF KANSAS  
STATE CORPORATION COMMISSION

Give All information Completely  
Make Required Affidavit  
Mail or Deliver Report to:  
Conservation Division  
State Corporation Commission  
211 No. Broadway  
Wichita, Kansas

WELL PLUGGING RECORD

Kingman County. Sec. 20 Twp. 27 S Rge. (E) 10 (W)  
Location as "NE/CNWSW" or footage from lines SW/4 SE/4  
Lease Owner Messman-Rinehart Oil Company  
Lease Name Gertrude Cannon Well No. 1  
Office Address 518 Petroleum Building, Wichita, Kansas  
Character of Well (completed as Oil, Gas or Dry Hole) Dry Hole  
Date well completed December 15 19 62  
Application for plugging filed December 15 19 62  
Application for plugging approved December 15 19 62  
Plugging commenced December 15 19 62  
Plugging completed December 15 19 62  
Reason for abandonment of well or producing formation Dry

NORTH

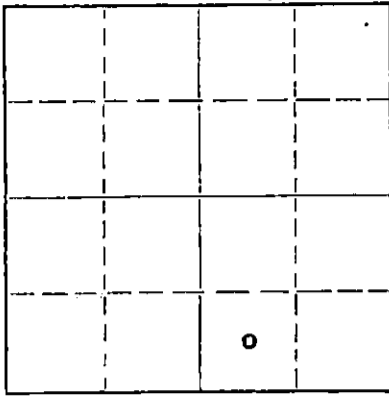

Locate well correctly on above  
Section Flat

If a producing well is abandoned, date of last production \_\_\_\_\_ 19 \_\_\_\_  
Was permission obtained from the Conservation Division or its agents before plugging was commenced? Herman Justus, Box 71, Nickerson, Kansas

Name of Conservation Agent who supervised plugging of this well \_\_\_\_\_  
Producing formation \_\_\_\_\_ Depth to top \_\_\_\_\_ Bottom \_\_\_\_\_ Total Depth of Well 3060 Feet  
Show depth and thickness of all water, oil and gas formations.

OIL, GAS OR WATER RECORDS

CASING RECORD

FORMATION	CONTENT	FROM	TO	SIZE	PUT IN	PULLED OUT
				10-3/4"	255'	none

Describe in detail the manner in which the well was plugged, indicating where the mud fluid was placed and the method or methods used in introducing it into the hole. If cement or other plugs were used, state the character of same and depth placed, from \_\_\_\_\_ feet to \_\_\_\_\_ feet for each plug set.

Set plug at 180 ft. with 25 sx. cement  
and set plug at 40 ft. with 15 sx. cement  
with hulis at each plug

RECEIVED  
STATE CORPORATION COMMISSION

JAN 9 1963

CONSERVATION DIVISION  
Wichita, Kansas

(If additional description is necessary, use BACK of this sheet)  
Name of Plugging Contractor Messman-Rinehart Oil Company  
Address 518 Petroleum Building, Wichita, Kansas

STATE OF Kansas, COUNTY OF Sedgwick, ss.  
J. A. Gilliland (employee of owner) of the above-described well, being first duly sworn on oath, says: That I have knowledge of the facts, statements, and matters herein contained and the log of the above-described well as filed and that the same are true and correct. So help me God.

(Signature) J. A. Gilliland  
518 Petroleum Building, Wichita, Kansas  
(Address)

SUBSCRIBED AND SWORN TO before me this 7th day of January, 19 63  
Barbara J. Scott  
Notary Public.

My commission expires December 1, 1964



NO. 1 GERTRUDE CANNON

Well Record:

Location: Ctr. SW/4 SE/4  
Section 20-275-10M  
Kingman County, Kansas

Contractor: Messman-Rinehart Oil Company  
518 Petroleum Building  
Wichita, Kansas

Operator: Messman-Rinehart Oil Company  
518 Petroleum Building  
Wichita, Kansas

Casing Record: 10-3/4" @ 255' w/250 sx. cement

Commenced: December 5, 1962  
Completed: December 15, 1962  
Elevation: 1687' K/B  
Production: D & A

\*\* L O G \*\*

Surface Sand	40
Sand	80
Red Bed & Clay	255
Red Bed & Shale	620
Shale & Red Bed	1350
Anhydrite	1380
Shale & Lime Streaks	1630
Lime & Shale	1880
Lime	1950
Lime & Shale	2216
Shale & Lime	2265
Shale & Sand	2347
Shale & Lime	2490
Shale	2594
Shale & Lime	2690
Lime	2720
Lime & Shale	3060 R.T.D.

Sample Logs:

2518' - Tarkio Lime (-831)  
2947' - Topoka (-1260)

The undersigned, MESSMAN-RINEHART OIL COMPANY, hereby certifies that the above log is a true and correct log of the formation encountered in drilling the above well as reflected by the Daily Drilling Reports.

MESSMAN-RINEHART OIL COMPANY

By: Roger L. Messman  
Roger L. Messman, Partner

Subscribed and sworn to before me  
this 7th day of January, 1963

Barbara J. Scott  
Barbara J. Scott, Notary Public

My Commission Expires: December 1, 1964

RECEIVED  
STATE CORPORATION COMMISSION

JAN 9 1963

CONSERVATION DIVISION  
Wichita, Kansas