


WELL PLUGGING RECORD

Give All Information Completely  
Make Required Affidavit  
Mail or Deliver Report to:  
Conservation Division  
State Corporation Commission  
212 No. Market  
Wichita, Kansas

NORTH

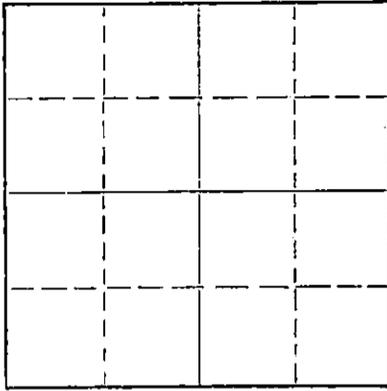

Locate well correctly on above  
Section Plat

Reno County, Sec. 6 Twp. 26 Rge. 7W (E) (W)  
Location as "NE/CNW/SW" or footage from lines NW NW SW  
Lease Owner Beverly Drilling Company  
Lease Name Smith Well No. 1  
Office Address Nickerson, Kansas  
Character of Well (completed as Oil, Gas or Dry Hole) D&A  
Date well completed 19  
Application for plugging filed July 20, 19 60  
Application for plugging approved July 6, 19 60  
Plugging commenced July 7, 19 60  
Plugging completed July 7, 19 60  
Reason for abandonment of well or producing formation

If a producing well is abandoned, date of last production 19  
Was permission obtained from the Conservation Division or its agents before plugging was commenced? YES

Name of Conservation Agent who supervised plugging of this well Fred W. Hampel  
Producing formation Depth to top Bottom Total Depth of Well 4306 Feet  
Show depth and thickness of all water, oil and gas formations.

OIL, GAS OR WATER RECORDS

CASING RECORD

FORMATION	CONTENT	FROM	TO	SIZE	PUT IN	PULLED OUT

Describe in detail the manner in which the well was plugged, indicating where the mud fluid was placed and the method or methods used in introducing it into the hole. If cement or other plugs were used, state the character of same and depth placed, from feet to feet for each plug set.

Heavy mud to 190' set plug used 1/4 sack hulls  
15 sacks cement through drill pipe. Mud to 35'  
set plug, used 1/4 sack hulls, 10 sacks cement  
to base of cellar.

Bridge rat hole used 2 sacks cement

RECEIVED  
STATE CORPORATION COMMISSION  
AUG 27 1968  
CONSERVATION DIVISION  
Wichita, Kansas

(If additional description is necessary, use BACK of this sheet)

Name of Plugging Contractor Company Tools  
Address

STATE OF KANSAS, COUNTY OF Sedgwick, ss.  
(employee of owner) or (owner or operator) of the above-described  
well, being first duly sworn on oath, says: That I have knowledge of the facts, statements, and matters herein contained and the log of the  
above-described well as filed and that the same are true and correct. So help me God.

(Signature) Lawell D. Brown



Sworn to before me this 27th day of August, 1968  
Seward S. Greider (Address)  
Notary Public.

Nov. 5, 1971