

STATE OF KANSAS
STATE CORPORATION COMMISSION

WELL PLUGGING RECORD

OR


FORMATION PLUGGING RECORD

Strike out upper line
when reporting plug-
ging off formations.

Give All Information Completely
Make Required Affidavit
Mail or Deliver Report to:
Conservation Division
State Corporation Commission
800 Bitting Building
Wichita, Kansas

Reno County, Sec. 10 Twp. 26 Rge. (E) 7 (W)

Location as "NE $\frac{1}{4}$ NW $\frac{1}{4}$ SW $\frac{1}{4}$ " or footage from lines Center SE $\frac{1}{4}$ SE $\frac{1}{4}$
Lease Owner J. J. Lynn
Lease Name V. Krehbiel Well No. 1
Office Address 701 Bitting Bldg., Wichita, Kansas
Character of Well (completed as Oil, Gas or Dry Hole) DRY
Date well completed December 5 19 42
Application for plugging filed December 7 19 42
Application for plugging approved December 7 19 42
Plugging commenced December 8 19 42
Plugging completed December 8 19 42
Reason for abandonment of well or producing formation All producing formations dry

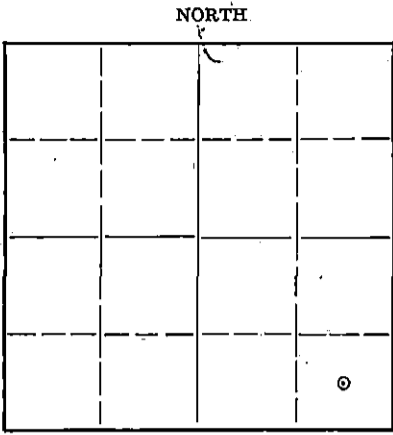

Locate well correctly on above
Section Plat


If a producing well is abandoned, date of last production 19...
Was permission obtained from the Conservation Division or its agents before plugging was com-
menced? Yes

Name of Conservation Agent who supervised plugging of this well Ruel Durkee
Producing formation Depth to top Bottom Total Depth of Well 4391 Feet

Show depth and thickness of all water, oil and gas formations.
OIL, GAS OR WATER RECORDS Well log attached CASING RECORD

Formation	Content	From	To	Size	Put In	Pulled Out
Red rock & shale		90	160	10	130	Cemented

Describe in detail the manner in which the well was plugged, indicating where the mud fluid was placed and the method or methods used in introducing it into the hold. If cement or other plugs were used, state the character of same and depth placed, from... feet to ... feet for each plug set.
Heavy mud circulated at 4391 and bridge in hole set at 130'. Cement from 130' to 106' through drill pipe. Heavy mud from 106' to 20' and cement through drill pipe from 20' to 6'. Soil from 6' to 0

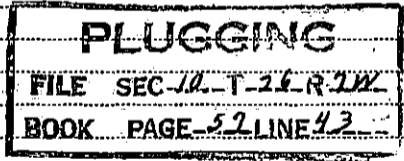

(If additional description is necessary, use BACK of this sheet)
Correspondence regarding this well should be addressed to J. J. Lynn, c/o H. M. Williams
Address 701 Bitting Bldg., Wichita, Kansas

STATE OF Kansas, COUNTY OF Sedgwick, ss.
H. M. Williams (employee of owner) or (owner or operator) of the above-described well,
being first duly sworn on oath, says: That I have knowledge of the facts, statements, and matters herein contained and the log of the above-described well as filed and that the same are true and correct. So help me God.

(Signature) *H. M. Williams*
701 Bitting Bldg., Wichita, Kansas
(Address)

SUBSCRIBED AND SWORN to before me this 10 day of December 19 42
[Signature]
Notary Public.

My commission expires March 4, 1944


12-12-1942

J. J. LYNN
Krehbiel No. 1.

SEC. 10 T. 26 R. 7 W
CSE SE

Total Depth. 4391' DFM
Comm. 10-15-42 Comp. 12-5-42
Shot or Treated.
Contractor. H.M. Williams
Issued. 12-12-42

County. Reno

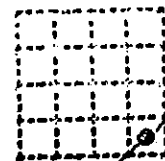

CASING:
10" 130' Cem.

Elevation.

Production. Dry

Figures Indicate Bottom of Formations.

soil	10	Tops:	
sand	90	Lansing-K.C.	3184
red rock & shale	160	Marmaton	3570
shale & shells	303	Conglomerate	3810
red rock & shale	411	Mississippi	3881
red rock	500	Kinderhook shale	4038
shale & shells	655	Misener sand	4245
anhydrite, shale,		Viola	4247
shells	825	Simpson formation	4273
shale & shells	1248	Arbuckle	4361
lime & shale	1348		
shale & shells	1490		
shale & lime shells	1590		
lime & shale	1730		
shale & shells	1840		
shale	2096		
shale & lime	2316		
shale	2340		
shale & shells	2505		
lime & shale	2555		
shale & shells	2685		
lime	2735		
shale & lime	2781		
lime	2860		
lime & shale	2970		
shale & brkn lime	3080		
lime	3150		
shale & lime	3207		
lime	3295		
lime & brkn lime	3329		
lime	3419		
lime & shale	3512		
lime	3578		
lime & shale	3634		
lime	3676		
shale	3719		
shale & lime	3810		
shale & lime shells	3823		
lime & shale	3877		
chert	3945		
lime & shale	3960		
lime & chert	3991		
shale	4010		
shale & shells	4055		
shale	4085		
shale & lime	4133		
shale	4264		
lime sdy	4266		
lime & sand	4275		
lime, shale, sand	4305		
shale sticky	4339		
lime & sand	4377		
lime	4391		
Total Depth. DFM eas.			

PLUGGING

