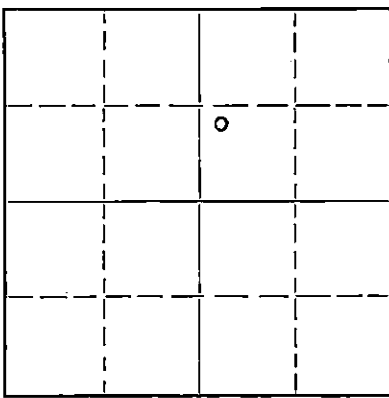


Give All Information Completely
Make Required Affidavit
Mail or Deliver Report to:
Conservation Division
State Corporation Commission
800 Bittling Building
Wichita, Kansas

WELL PLUGGING RECORD

NORTH

Locate well correctly on above
Section Plat

Reno County, Sec. 3 Twp. 26 Rge. 4 (E) W. (W)
Location as "NE/CNW $\frac{1}{4}$ SW $\frac{1}{4}$ " or footage from lines NW SW NE
Lease Owner The Derby Oil Company
Lease Name Burdorf Well No. 1
Office Address Box 1030, Wichita, Kansas
Character of Well (completed as Oil, Gas or Dry Hole) Dry Hole
Date well completed March 13, 1953
Application for plugging filed March 30, 1953
Application for plugging approved March 17, 1953
Plugging commenced March 13, 1953
Plugging completed March 13, 1953
Reason for abandonment of well or producing formation Dry Hole
If a producing well is abandoned, date of last production 19--
Was permission obtained from the Conservation Division or its agents before plugging was commenced? Yes

Name of Conservation Agent who supervised plugging of this well Ruel Durkee
Producing formation Dry Depth to top Bottom Total Depth of Well 3360 Feet
Show depth and thickness of all water, oil and gas formations.

OIL, GAS OR WATER RECORDS

CASING RECORD

Formation	Content	From	To	Size	Put In	Pulled Out
				8 5/8"	195	None

Describe in detail the manner in which the well was plugged, indicating where the mud fluid was placed and the method or methods used in introducing it into the hole. If cement or other plugs were used, state the character of same and depth placed, from feet to feet for each plug set.

3360 - 185 Heavy Rotary Mud
185 - 184 Wooden Plug
184 - 140 Cement - 15 sacks
140 - 15 Heavy Rotary Mud
15 - Surface Cement - 5 sacks

RECEIVED
STATE CORPORATION COMMISSION
FEB 1 1953
CONSERVATION DIVISION
Wichita, Kansas

4-1-1953

(If additional description is necessary, use BACK of this sheet)
Name of Plugging Contractor Saturn Drilling, Inc.
Address 102 Insurance Bldg.
Wichita, Kansas

STATE OF KANSAS, COUNTY OF SEDGWICK, ss.
W. W. Clements (employee of owner) or owner or operator of the above-described well,
being first duly sworn on oath, says: That I have knowledge of the facts, statements, and matters herein contained and the log of the above-described well as filed and that the same are true and correct. So help me God.

(Signature)

Box 1030, Wichita, Kansas
(Address)

SUBSCRIBED AND SWORN to before me this 30th day of March, 1953

Commission expires August 24, 1953

23-8390-s 6-51-20M

Notary Public.

PLUGGING
FILE SEC 3 T 26 R 4
BOOK PAGE 15 LINE 3