


WELL PLUGGING RECORD

Give All Information Completely
Make Required Affidavit
Mail or Deliver Report to:
Conservation Division
State Corporation Commission
212 North Market, Insurance Bldg.
Wichita, Kansas

Reno County, Sec. 3 Twp. 26 Rge. 4 (E) W (W)
Location as "NE/CNW/SW" or footage from lines 330'SL - 330'EL - lot 3
Lease Owner Saturn Drilling, Inc. Co., Inc.
Lease Name Nicklaus #1 Well No.
Office Address Denver, Colorado
Character of Well (completed as Oil, Gas or Dry Hole)
Date well completed 19____
Application for plugging filed 19____
Application for plugging approved 19____
Plugging commenced 6-3-59 19____
Plugging completed 6-5-59 19____
Reason for abandonment of well or producing formation

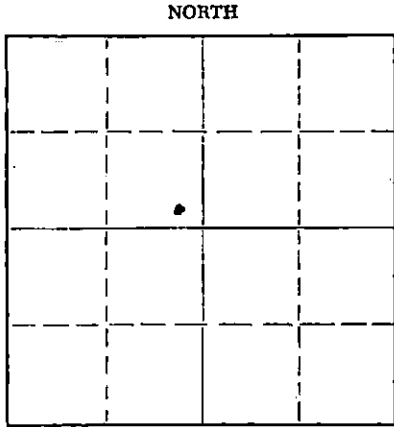

Locate well correctly on above Section Plat

If a producing well is abandoned, date of last production 19____
Was permission obtained from the Conservation Division or its agents before plugging was commenced? yes

Name of Conservation Agent who supervised plugging of this well Fred Hampel
Producing formation _____ Depth to top _____ Bottom _____ Total Depth of Well 4243 Feet
Show depth and thickness of all water, oil and gas formations.

OIL, GAS OR WATER RECORDS

CASING RECORD

FORMATION	CONTENT	FROM	TO	SIZE	PUT IN	PULLED OUT
				8-5/8"	195'	none
				5-1/2"	3330'	2998'

Describe in detail the manner in which the well was plugged, indicating where the mud fluid was placed and the method or methods used in introducing it into the hole. If cement or other plugs were used, state the character of same and depth placed, from _____ feet to _____ feet for each plug set.

Checked the hole to 3277' and found it open.
Filled w/sand to 3230' and dumped 5 sacks of cement with bailer. Pulled KM 5 1/2" casing, cleaned hole and mudded the hole from 450' to 190', set rock bridge to 180' and dumped 20 sacks of cement. Mudded the hole to 35', set 10' rock bridge and ran 10 sacks of cement to base of cellar.

RECEIVED
STATE CORPORATION COMMISSION

SEP 18 1959

PLUGGING COMPLETED

CONSERVATION DIVISION
Wichita, Kansas

(If additional description is necessary, use BACK of this sheet)
Name of Plugging Contractor Knight Casing Pulling Co.
Address Chase, Kansas

STATE OF KANSAS, COUNTY OF RICE, ss.
I, Noel J. Knight (employee of owner) or (owner) of the above-described well, being first duly sworn on oath, says: That I have knowledge of the facts, statements, and matters herein contained and the log of the above-described well as filed and that the same are true and correct. So help me God.

(Signature) *Noel J. Knight*
Chase, Kansas (Address)

SUBSCRIBED AND SWORN to before me this 12th day of June, 19 59

My commission expires 9-27-62

Thomas V. Boyer
Notary Public.

PLUGGING

File Sec. 3 T 26 R 40
Book Page 2 Line 24

WELL LOG BUREAU—KANSAS GEOLOGICAL SOCIETY **COPY**
 503 East Main Street, Wichita, Kansas


15-155-60370-0000

Company: SATURN DRILLING, INC.
 Farm: Nicklaus No. 1

SEC. 3 T. 26 R. 4W
 SE SE NW

Total Depth. 4243
 Comm. 10-2-52
 Shot or Treatment.
 Contractor.
 Logged. 3-7-53

County Reno KANSAS

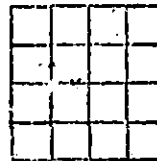

CASING:
 8 5/8" 195'

Elevation. 1534 RB

Production. 87 BO & 64% wtr.

Figures indicate Bottom of Formations.

shale & shells	935
lime & shale	1255
lime	1320
lime & shale	1570
shale & shells	1790
shale & lime	1965
shale & shells	2375
lime	2500
shale & lime	2560
lime	2590
shale & lime	2690
lime	2750
shale & shells	2760
shale & lime	2809
lime	3257
T.D.	3257
producing gas	
lime	3340
lime & shale	3657
chert & lime	3681
lime	3843
lime & chert	3865
lime	3981
shale & lime	4053
shale	4116
lime	4119
simpson sand	4150
sand & shale	4162
shale	4215
arbuckle	4243
Total Depth	

Tops:	
Heebner	2617
Brown Lime	2807
Lansing	2841
Conglomerate	3646
Miss.	3657
Kinderhook	3981
Misener	4082
Viola	4105
Simpson	4118
Arbuckle	4213

1536 2171