


STATE OF KANSAS
STATE CORPORATION COMMISSION

Give All Information Completely
Make Required Affidavit
Mail or Deliver Report to:
Conservation Division
State Corporation Commission
212 North Market, Insurance Bldg.
Wichita, Kansas

WELL PLUGGING RECORD

Kingman County, Sec. 9 Twp. 29S Rge. (X) 6 (W)

Location as "NE/CNW/SW" or footage from lines 1830' WEL & 600' NSL
Lease Owner Gulf Oil Corporation
Lease Name Shipley Well No. 1
Office Address 316 Union Center, Wichita 2, Kansas
Character of Well (completed as Oil, Gas or Dry Hole) Dry Hole
Date well completed Sept. 14, 19 60
Application for plugging filed (Orally) Sept. 13, 19 60
Application for plugging approved (Orally) Sept. 13, 19 60
Plugging commenced Sept. 13, 19 60
Plugging completed Sept. 14, 19 60
Reason for abandonment of well or producing formation Dry Hole

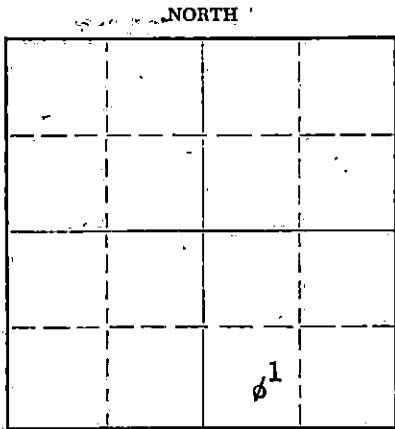

Locate well correctly on above Section Plat

If a producing well is abandoned, date of last production 19
Was permission obtained from the Conservation Division or its agents before plugging was commenced? Yes

Name of Conservation Agent who supervised plugging of this well Fred Hampel
Producing formation Depth to top Bottom Total Depth of Well 4130 Feet
Show depth and thickness of all water, oil and gas formations.

OIL, GAS OR WATER RECORDS

CASING RECORD

FORMATION	CONTENT	FROM	TO	SIZE	PUT IN	PULLED OUT
		0	282	8-5/8"	280	0

Describe in detail the manner in which the well was plugged, indicating where the mud fluid was placed and the method or methods used in introducing it into the hole. If cement or other plugs were used, state the character of same and depth placed, from feet to feet for each plug set.

Filled hole with mud to 240'. Set HOWCO plug w/ 1/4 sack of hulls at 240'. Cemented to 180' w/ 20 sacks. Mudded hole to 35'. Installed HOWCO plug w/ 1/4 sack of hulls at 35'. Cemented hole to base of cellar w/ 12 sacks.

RECEIVED
STATE CORPORATION COMMISSION

SEP 21 1960

CONSERVATION DIVISION
Wichita, Kansas

9-21-1960

(If additional description is necessary, use BACK of this sheet)
Name of Plugging Contractor Capitt Drilling, Inc.
Address 814 Union Center, Wichita 2, Kansas

STATE OF KANSAS, COUNTY OF SEDGWICK, ss.
G. V. Kersten (employee of owner) of the above-described well, being first duly sworn on oath, says: That I have knowledge of the facts, statements, and matters herein contained and the log of the above-described well as filed and that the same are true and correct. So help me God.

(Signature) G. V. Kersten
316 Union Center, Wichita 2, Kansas
(Address)

SUBSCRIBED AND SWORN to before me this 16th day of September, 19 60

My commission expires 2-4-63

Ray W. Rouser
Notary Public.

ROTARY DRILLING LOG

OPERATOR: Gulf Oil Corporation
Shipley #1
C SW SE Sec. 9-29S-6W,
Kingman County, Kansas

CONTRACTOR: Capitt Drilling, Inc.
COMP: 9-1-60
COMP: 9-14-60

Formations:

Sand	35'
Red Rock	285'
Red Bed	320'
Shale & Shells	1100'
Lime & Shale	1335'
Lime	1650'
Lime & Shale	1845'
Shale w/lime streaks	2045'
Shale & Lime	2865'
Lime w/Shale brks.	3023'
Lime & Shale	3307'
Lime	3803'
Lime & Shale	4087'
Mississippi	4105'
Chat & Chert	4113'
Chert & Dolomite	4130'

Rotary Total Depth
(D&A) 4130'

Remarks: Set 270' of 8-5/8" surface casing at 282' cemented with 110 sacks common cement w/10% gel & 30 sk. Common w/3% C.C.

RECEIVED
STATE COMMISSION
OCT 20 1960
CONSERVATION DIVISION
Wichita, Kansas

We certify the above log is true and correct to the best of our knowledge and belief.

CAPITT DRILLING, INC.

R. R. McNicol
R. R. McNicol