


STATE OF KANSAS  
STATE CORPORATION COMMISSION

Form CP-4

Give All Information Completely  
Make Required Affidavit  
Mail or Deliver Report to:  
Conservation Division  
State Corporation Commission  
211 No. E. Broadway  
Wichita, Kansas

WELL PLUGGING RECORD

Seward County, Sec. 34 Twp. 32S Rge. 33W (B) (W)  
Location as "NE/CNW/SW" or footage from lines 1250' FNL, 1250' FEL  
Lease Owner Malonee-Mahoney Drilling Co.  
Lease Name Lemert Well No. 1  
Office Address P.O. Box 1257, Liberal, Kansas 67901  
Character of Well (completed as Oil, Gas or Dry Hole) DRY HOLE  
Date well completed 3/29 19 71  
Application for plugging filed 3/29 19 71  
Application for plugging approved 3/30 19 71  
Plugging commenced 4/2/ 19 71  
Plugging completed 4/2/ 19 71  
Reason for abandonment of well or producing formation DRY HOLE

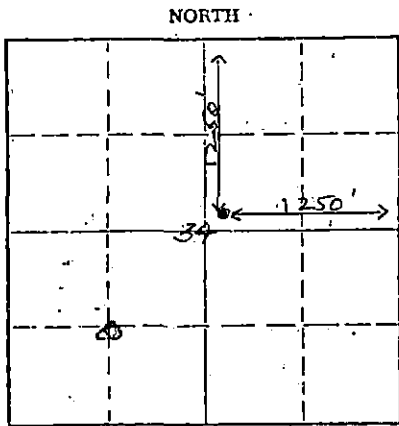

Locate well correctly on above  
Section Plat

If a producing well is abandoned, date of last production \_\_\_\_\_ 19 \_\_\_\_  
Was permission obtained from the Conservation Division or its agents before plugging was commenced? YES

Name of Conservation Agent who supervised plugging of this well ED EVES  
Producing formation \_\_\_\_\_ Depth to top \_\_\_\_\_ Bottom \_\_\_\_\_ Total Depth of Well 2525 1/2 Feet  
Show depth and thickness of all water, oil and gas formations.

OIL, GAS OR WATER RECORDS

CASING RECORD

FORMATION	CONTENT	FROM	TO	SIZE	PUT IN	PULLED OUT

Describe in detail the manner in which the well was plugged, indicating where the mud fluid was placed and the method or methods used in introducing it into the hole. If cement or other plugs were used, state the character of same and depth placed, from \_\_\_\_\_ feet to \_\_\_\_\_ feet for each plug set.

Top perfs 2,433'. Mix 20 sks. cement and stop plug at 2,300'.  
Spot 20 sks. cement at 900' to 750'.  
10 sks. cement at 60' to 0'.

RECEIVED  
STATE CORPORATION COMMISSION  
APR 12 1971  
CONSERVATION DIVISION  
Wichita, Kansas

(If additional description is necessary, use BACK of this sheet)  
Name of Plugging Contractor SARGENT'S CASING PULLING SERVICE.  
Address Box 506, Liberal, Kansas 67901

STATE OF KANSAS COUNTY OF SEWARD, ss.  
CHESTER A. NORDLING ~~owner or operator~~ owner or operator of the above-described

well, being first duly sworn on oath, says: That I have knowledge of the facts, statements, and matters herein contained and the log of the above-described well as filed and that the same are true and correct. So help me God. SARGENT'S CASING PULLING SERVICE

(Signature) Chester A. Nordling Partner  
Liberal, Kansas 67901  
(Address)

SUBSCRIBED AND SWORN TO before me this 8th day of April, 19 71  
Mona M. Clark

MONA M. CLARK  
My commission expires \_\_\_\_\_  
Notary Public

MONA M. CLARK  
NOTARY PUBLIC  
Seward County, Kansas  
My Commission Expires  
Sept. 18, 1974

Notary Public.

# WELL LOG

COMPANY Mallonee-Mahoney, Inc.

SEC. 34 T. 32 R. 33W

FARM Lumbert NO. 1


LOC. 1250' From NL and  
1250' From EL

TOTAL DEPTH 2550'

COUNTY Seward County

COMM. 8-29-70 COMP. 9-1-70

CONTRACTOR Zenith Drilling Corporation, Inc.

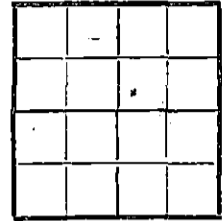

CASING

5 1/2" @ 2549' w/500 sx.

ELEVATION

PRODUCTION Gas

FIGURES INDICATE BOTTOM OF FORMATIONS

- 90' - Surface Sand
- 1040' - Sand - Red Bed
- 1956' - Sand - Red Bed - Anhydrite
- 2550' - Red Bed - Gypsum - Anhydrite
- TD

RECEIVED  
STATE CORPORATION COMMISSION  
APR 13 1971  
CONSERVATION DIVISION  
Wichita, Kansas

State of Kansas }  
County of Sedgwick } ss

I, C. Robert Buford of Wichita, Kansas

upon oath state the above and foregoing is a true and correct copy of the log of the Lumbert #1 well.

*C. Robert Buford*

Subscribed and sworn to before me this 15th day of September 19 70.

My Commission Expires: August 15, 1971.

*Myron L. Murky*  
NOTARY PUBLIC