

STATE OF KANSAS
STATE CORPORATION COMMISSION

WELL PLUGGING RECORD

Give All Information Completely
Make Required Affidavit
Mail or Deliver Report to:
Conservation Division
State Corporation Commission
212 North Market, Insurance Bldg.
Wichita, Kansas

Seward

County, Sec. 34 Twp. 32S Rge. 33 ~~W3E~~ (W)

Location as "NE/CNW/SW" or footage from lines 2340' FNL & 2340' FWL

Lease Owner Pan American Petroleum Corporation

Lease Name B. H. Lemert Well No. 2

Office Address Box 432, Liberal, Kansas

Character of Well (completed as Oil, Gas or Dry Hole) Gas

Date well completed 11-30 1963

Application for plugging filed 12-6 1965

Application for plugging approved 12-7 1965

Plugging commenced 12-29 1965


Plugging completed 12-29 1965

Reason for abandonment of well or producing formation Economically Depleted

If a producing well is abandoned, date of last production 7-16 19 65

Was permission obtained from the Conservation Division or its agents before plugging was commenced? Yes

NORTH

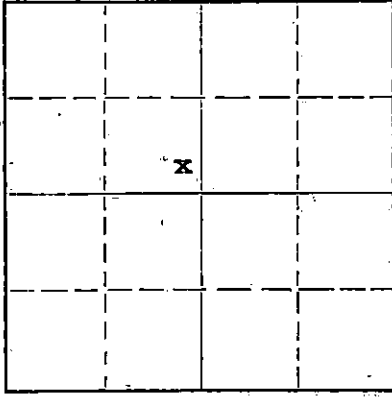

Locate well correctly on above Section Plat

Name of Conservation Agent who supervised plugging of this well Hugh Scott

Producing formation Herrington Depth to top 2532 Bottom 2562 Total Depth of Well 2645 Feet

Show depth and thickness of all water, oil and gas formations.

OIL, GAS OR WATER RECORDS

CASING RECORD

FORMATION	CONTENT	FROM	TO	SIZE	PUT IN	PULLED OUT
Herrington	Gas	2532	2562	8-5/8	507	None
				4-1/2	2648	None

Describe in detail the manner in which the well was plugged, indicating where the mud fluid was placed and the method or methods used in introducing it into the hole. If cement or other plugs were used, state the character of same and depth placed, from _____ feet to _____ feet for each plug set.

Halliburton Company pumped in 288 sq. cement Maximum pressure 600# shut-in pressure 150# 4 1/2" casing full cement from bottom to surface

RECEIVED
STATE CORPORATION COMMISSION
JAN 5 1966
CONSERVATION DIVISION
Wichita, Kansas

1-5-1966

(If additional description is necessary, use BACK of this sheet)

Name of Plugging Contractor Halliburton Company
Address Liberal, Kansas

STATE OF KANSAS, COUNTY OF SEWARD, ss.
I, D. M. Liles (employee of owner) or (operator) of the above-described

well, being first duly sworn on oath, says: That I have knowledge of the facts, statements, and matters herein contained and the log of the above-described well as filed and that the same are true and correct. So help me God.

(Signature) D M Liles
Box 432, Liberal, Kansas
(Address)

SUBSCRIBED AND SWORN to before me this 4 day of January, 19 66

My commission expires February 11, 1968

Rus Banks
Notary Public.



FORMATION RECORD

DESCRIBE EACH FORMATION DRILLED. INDICATE THICKNESS, CONTENT AND WHETHER DRY, OR OIL, GAS, OR WATER BEARING.

FORMATION	TOP	BOTTOM	FORMATION	TOP	BOTTOM
Surface-sand-red bed	0	1690			
Shale-lime	1690	1923			
Lime	1923	1940			
Shale-lime	1940	2320			
Lime	2320	2438			
Shale-lime	2438	2569			
Lime	2569	2645			
Total depth	2645				
Plug back depth	2562				