


STATE OF KANSAS
STATE CORPORATION COMMISSION

Give All Information Completely
Make Required Affidavit
Mail or Deliver Report to
Conservation Division
State Corporation Commission
245 North Water
Wichita, KS 67202

FORM CP-4

WELL PLUGGING RECORD

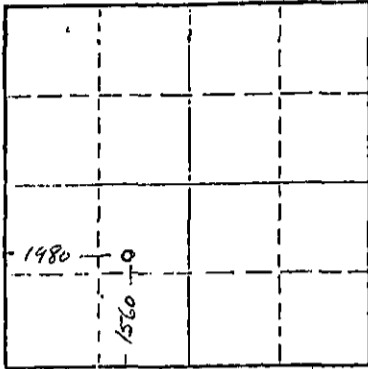

Locate well correctly on above
Section Plot

Seward County, Sec. 34 Twp. 32S Rge. 33W (E) (W)
Location as "NE/CNW/SE/SW" or footage from lines 1/2 E/2 SW
Lease Owner O-KAN Fluid Service, Inc. - PMC, Inc.
Lease Name Lemert Unit Well No. 1
Office Address Box 1259 Liberal, Kansas 67901
Character of Well (completed as Oil, Gas or Dry Hole) SWD
Date well completed 6-1-71
Application for plugging filed 12-7 19 76
Application for plugging approved 12-9 19 76
Plugging commenced 12-13 19 76
Plugging completed 12-14 19 76
Reason for abandonment of well or producing formation
LANDOWNER REVOKED LEASE AGREEMENT
If a producing well is abandoned, date of last production 19
Was permission obtained from the Conservation Division or its agents before plugging was commenced? Yes

Name of Conservation Agent who supervised plugging of this well Clarence Thomas
Producing formation _____ Depth to top _____ Bottom _____ Total Depth of Well 6020 Feet
Show depth and thickness of all water, oil and gas formations.

OIL, GAS OR WATER RECORDS

CASING RECORD

FORMATION	CONTENT	FROM	TO	SIZE	PUT IN	PULLED OUT
				8 5/8	1550	none
				4 1/2	6017	2500

Describe in detail the manner in which the well was plugged, indicating where the mud fluid was placed and the method or methods used in introducing it into the hole. If cement or other plugs were used, state the character of same and depth placed, from _____ feet to _____ feet for each plug set.

Pump 2 sks. of hulls & 10 sks. of cement from 4250
Pump 35 sks. of cement from 1600 to 1500
Put 15 sks. of cement from 40 to 0

RECEIVED
STATE CORPORATION COMMISSION
DEC 23 1976

(If additional description is necessary, use BACK of this sheet)
Name of Plugging Contractor Sargents Casing Pulling Service
Address Box 506 Liberal, Kansas 67901

STATE OF Kansas COUNTY OF Seward ss.
P-M-C, Inc. (employee of owner) or (owner or operator) of the above-described

well, being first duly sworn on oath, says: That I have knowledge of the facts, statements, and matters herein contained and the log of the above-described well as filed and that the same are true and correct. So help me God.

(Signature) [Signature] Sec-Treas.

P. O. Box 1259, Liberal, Ks. 67901
(Address)

SUBSCRIBED AND SWORN TO before me this 21st day of December, 19 76

My commission expires September 3, 1979

[Signature]
Notary Public.

